


T.31 S.R.15 W.W.M.

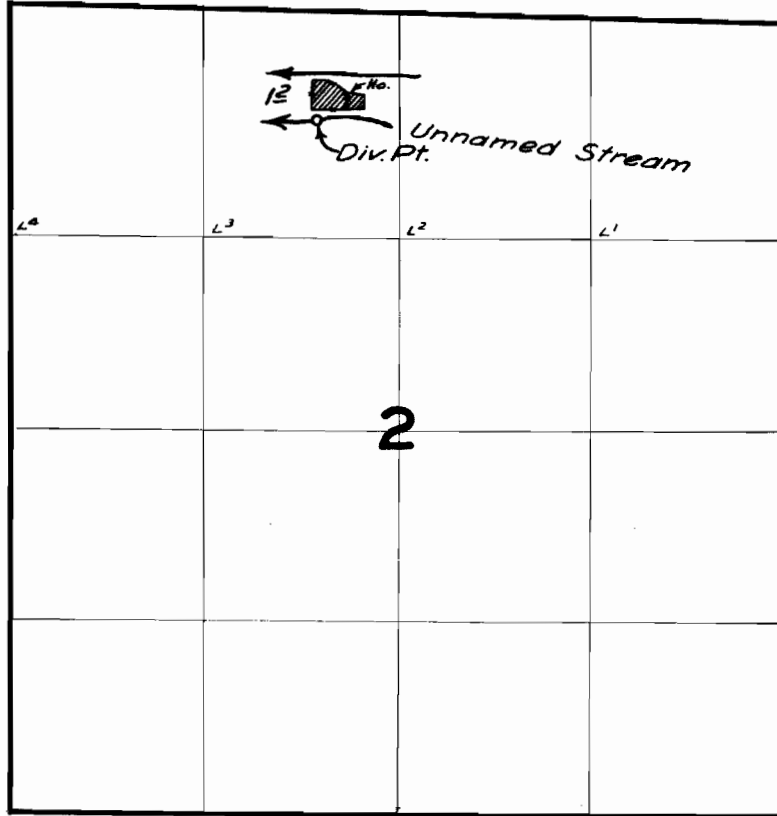

FINAL PROOF SURVEY
UNDER

Application No. 27887 Permit No. 21967
IN NAME OF

M.H. Alger

Surveyed 22 April 1958, by m. Bish