


T.6S. R.1E.W.M.

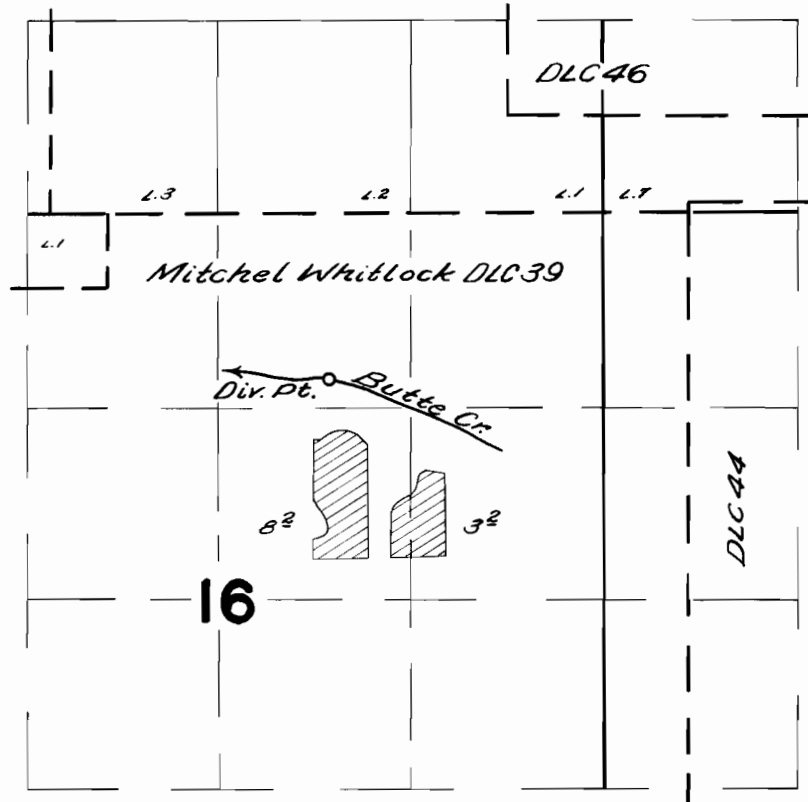

FINAL PROOF SURVEY UNDER

Application No. *28277* Permit No. *22233*
IN NAME OF

Robert F Cook

Surveyed *April 21* 1958, by *C. A. Bartels*