


T.2N.R.16 E.W.M.

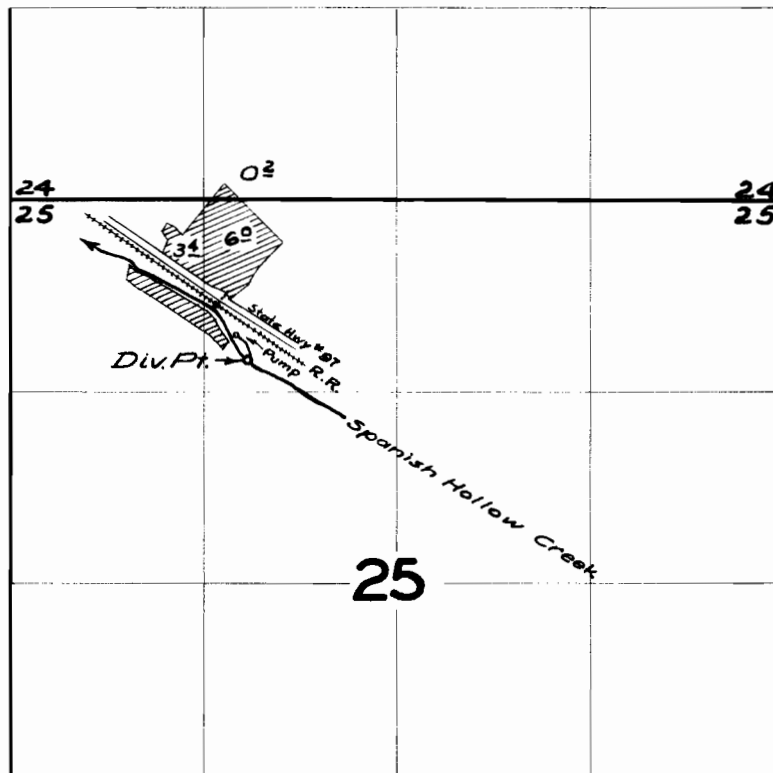

FINAL PROOF SURVEY
UNDER

Application No. 28567 Permit No. 22341
IN NAME OF

LEONARD & NERINE FIELDS

Surveyed 30 Oct. 1958, by Wm. Rich