


T. IN. R. I W. W.M.

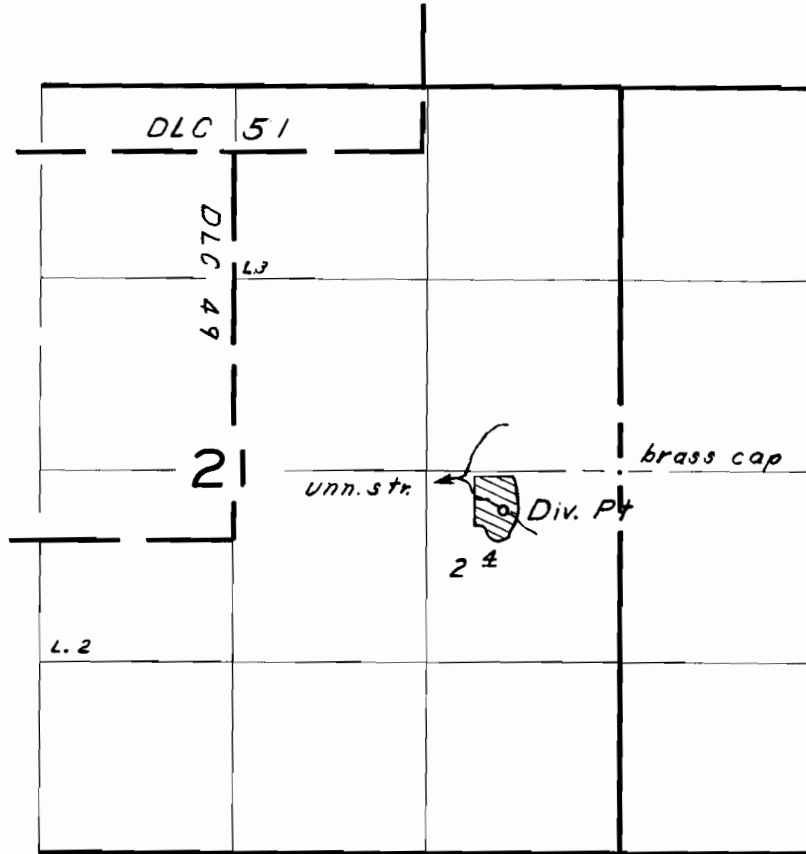

FINAL PROOF SURVEY
UNDER

Application No. 28249 . Permit No. 22353
IN NAME OF

Samuel E. Shimmens

Surveyed *May 6, 1958* by *R. H. Whitby*