


T. 3S. R. 2E. W.M.

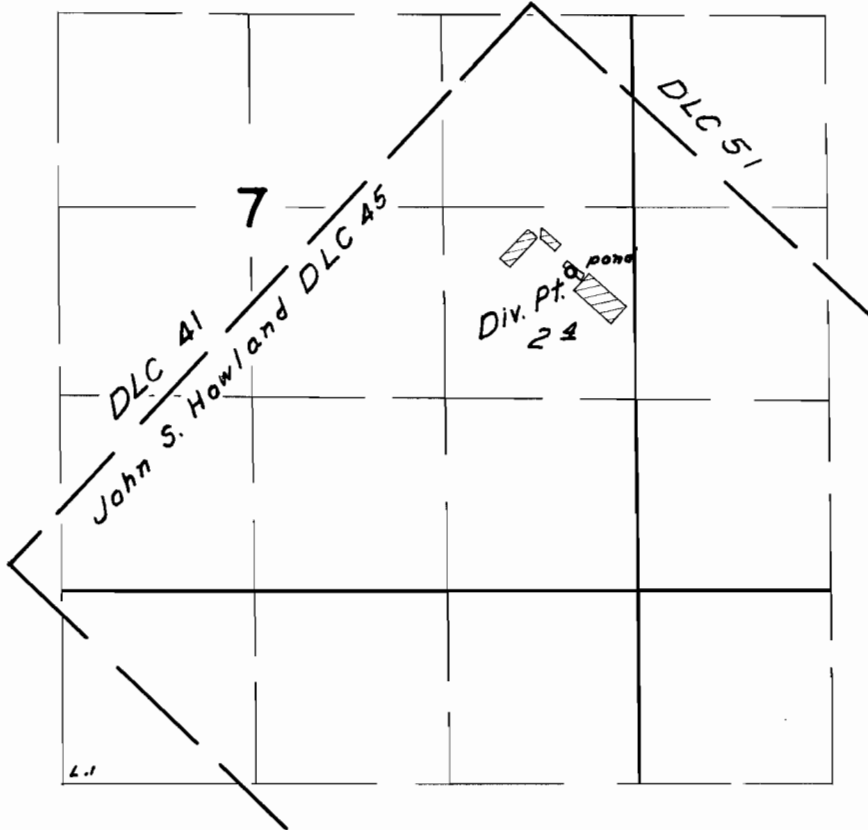

FINAL PROOF SURVEY
UNDER

Application No. 28305 Permit No. 22450
IN NAME OF

Peter Jacobs

Surveyed July 2 1958, by W.N. Perry