


T.30&31 S.R.12W.W.M.

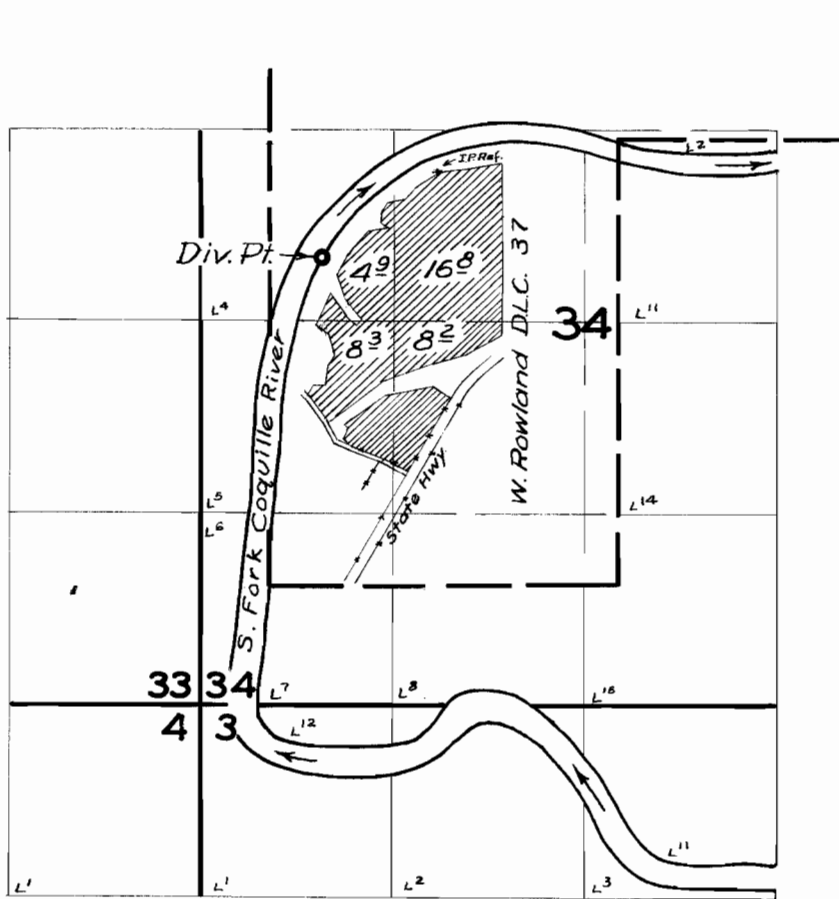

FINAL PROOF SURVEY UNDER

Application No. 28433 Permit No. 22488
IN NAME OF

McLeod Construction Co.

Surveyed 18 June 1958, by M. A. Seab