T. 3S. R. 2E. W.M.

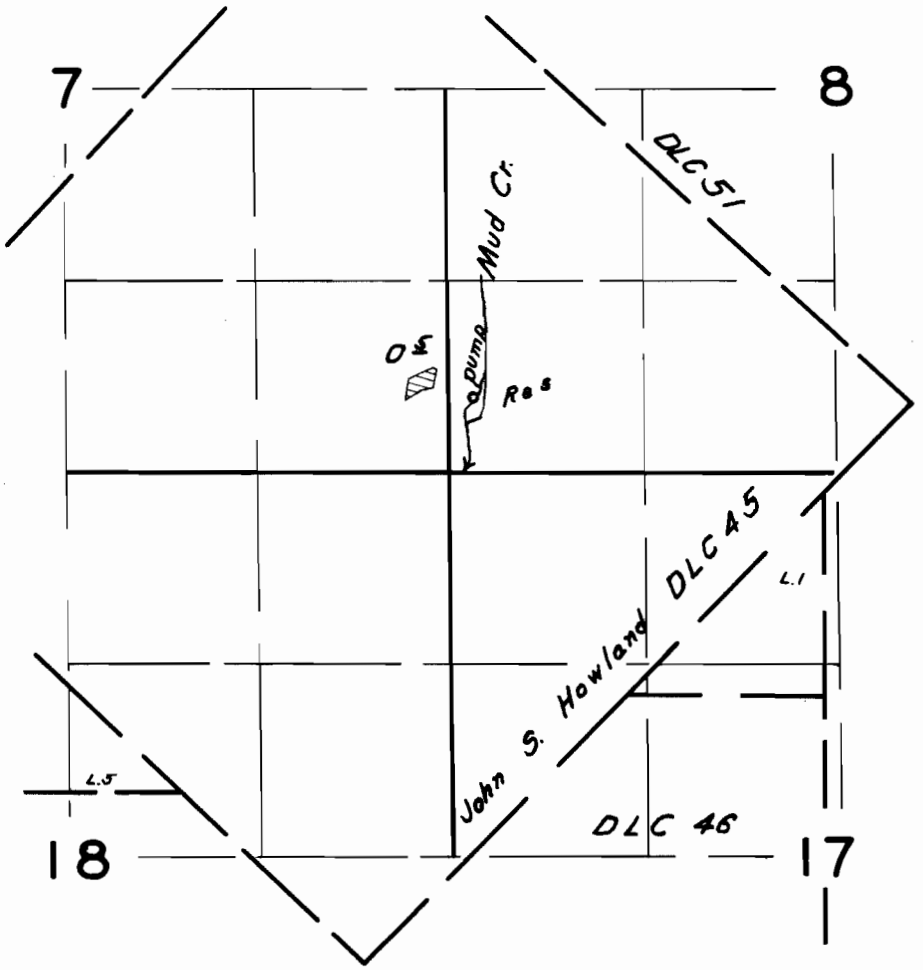

FINAL PROOF SURVEY

UNDER

Application No. R-28596 28597 Permit No. R-1545 22529

IN NAME OF

S. Ely

Surveyed July 1 1958, by W.N. Perry

1958-N¢ DFK-3D-127