


T. 2S. R. 2E. W. M.

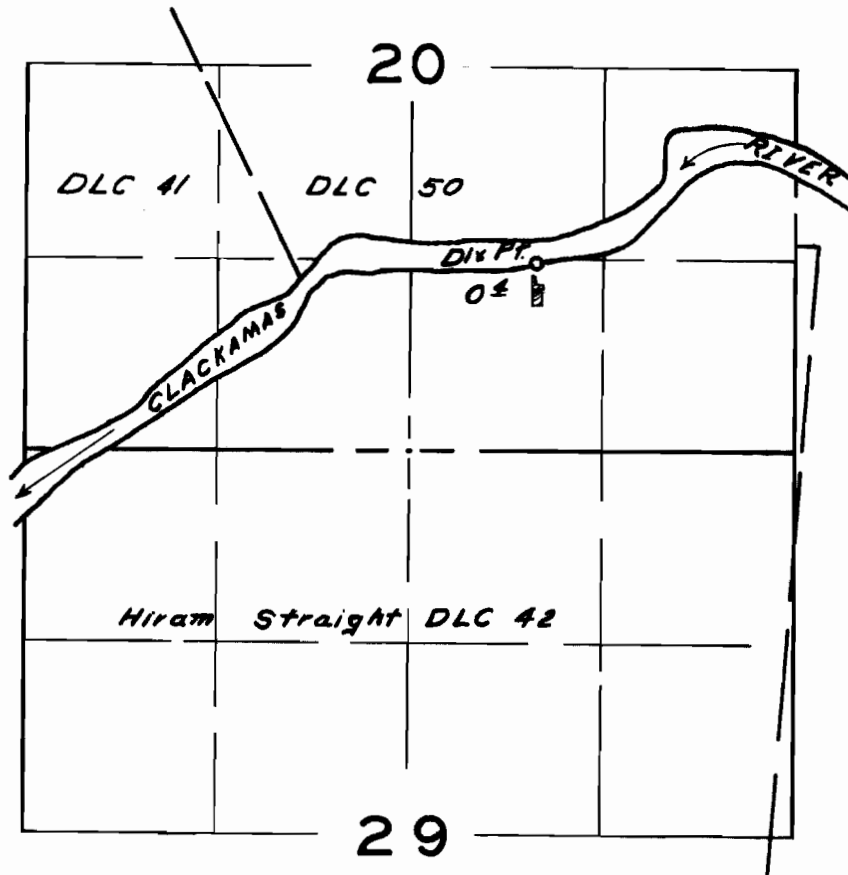

**FINAL PROOF SURVEY**  
UNDER

Application No. ~~28844~~ Permit No. ~~22693~~  
IN NAME OF

*Dallas G. Dunmire*

Surveyed *July 8* 1958, by *W.N. Perry*