


T.30S.R.5 W.W.M.

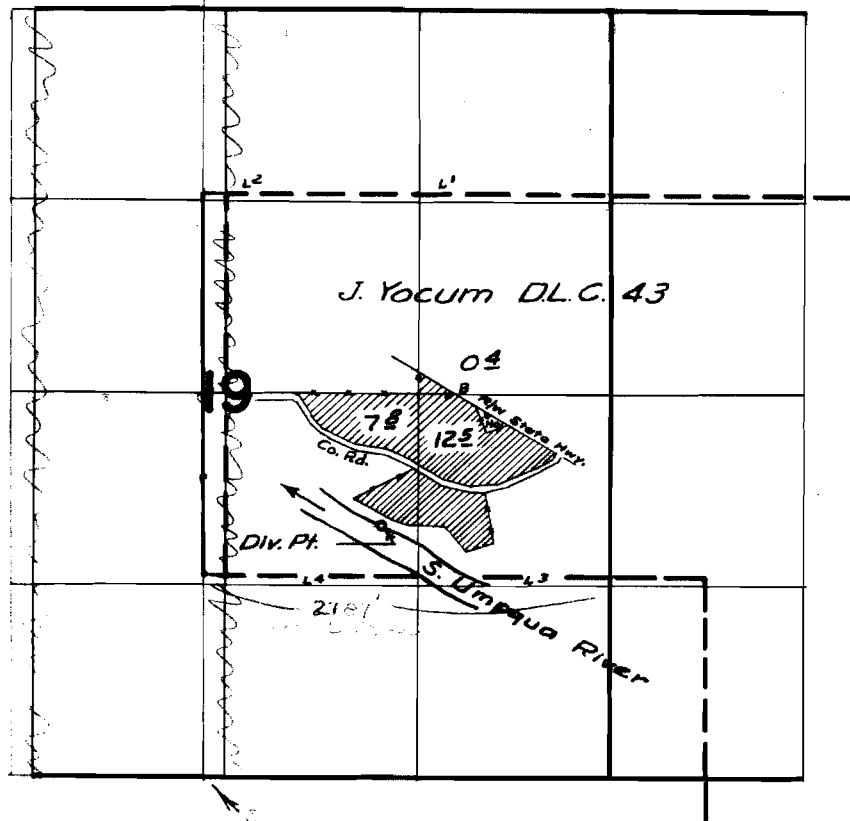

FINAL PROOF SURVEY UNDER

Application No. 28666 Permit No. 22742
IN NAME OF

MELVIN G. COFFMAN

Surveyed 11 Sept. 1958, by M. Rich