


T. 22S. R. 32 1/2 E. W.M.

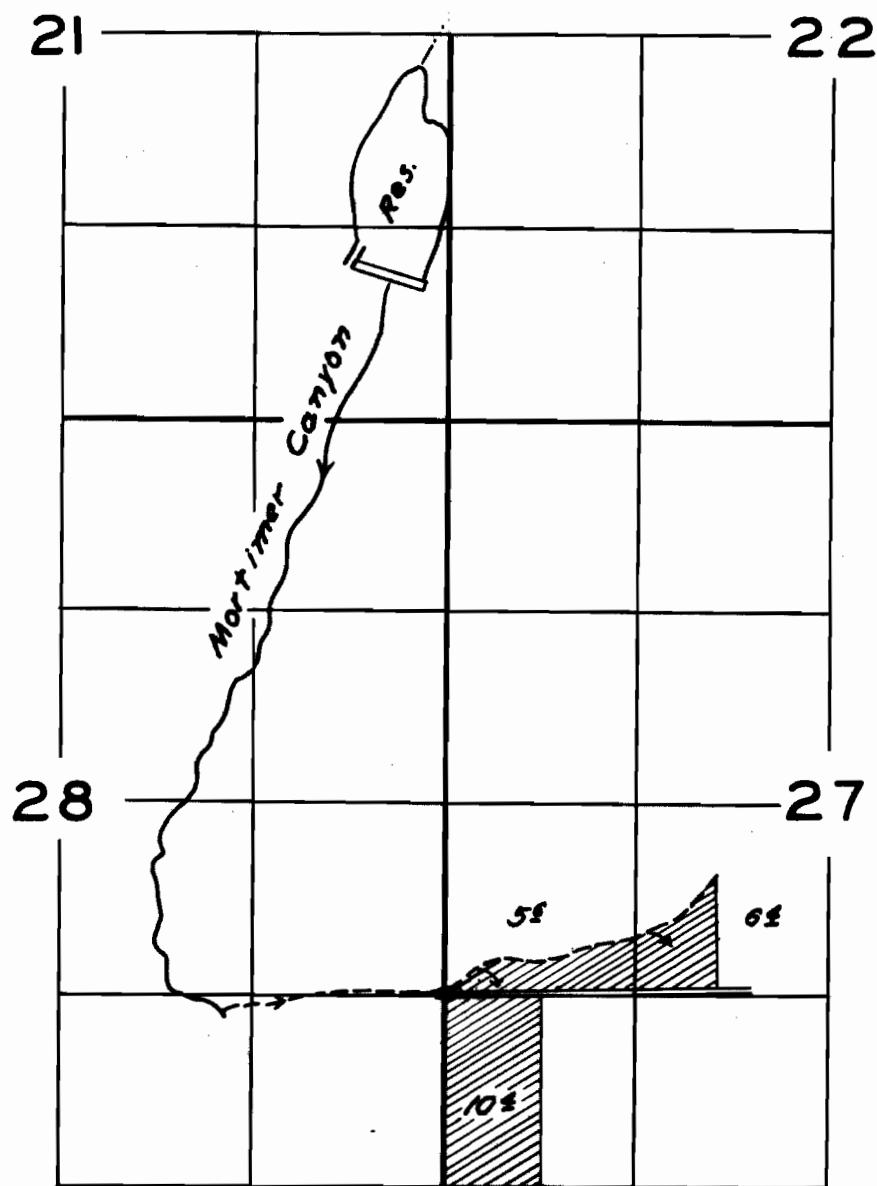

FINAL PROOF SURVEY
UNDER

Application No. 28954 Permit No. 22773
IN NAME OF

Frank E. Smith

Surveyed Aug. 21, 1958, by W. N. Perry