


T. 22S. R. 32 1/2 E. W. M.

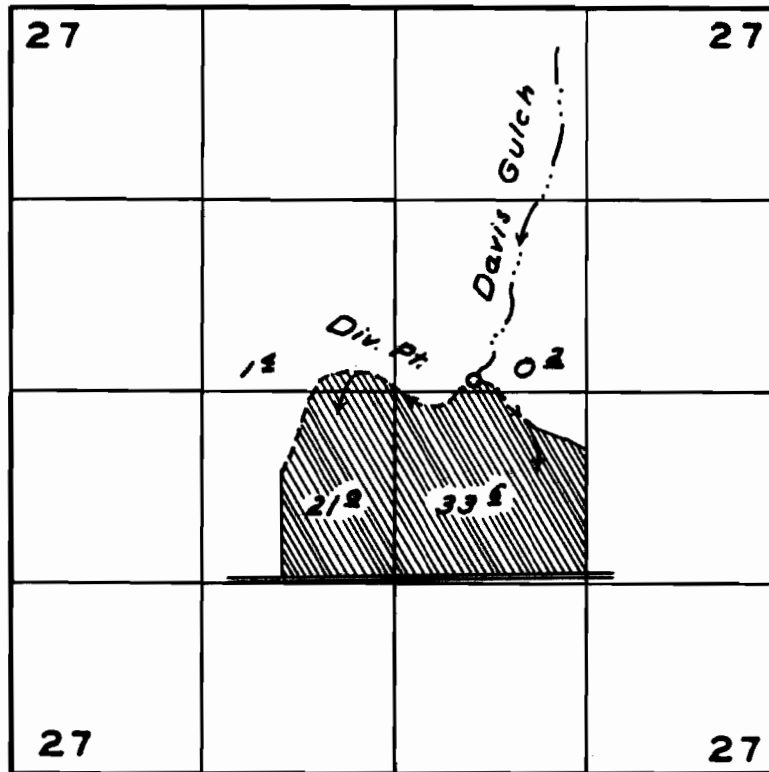

FINAL PROOF SURVEY
UNDER

Application No. ~~20955~~ Permit No. ~~22774~~
IN NAME OF

Frank E. Smith

Surveyed Aug. 21, 1958, by W. M. Perry