


# T.5S. R.1W.W.M.

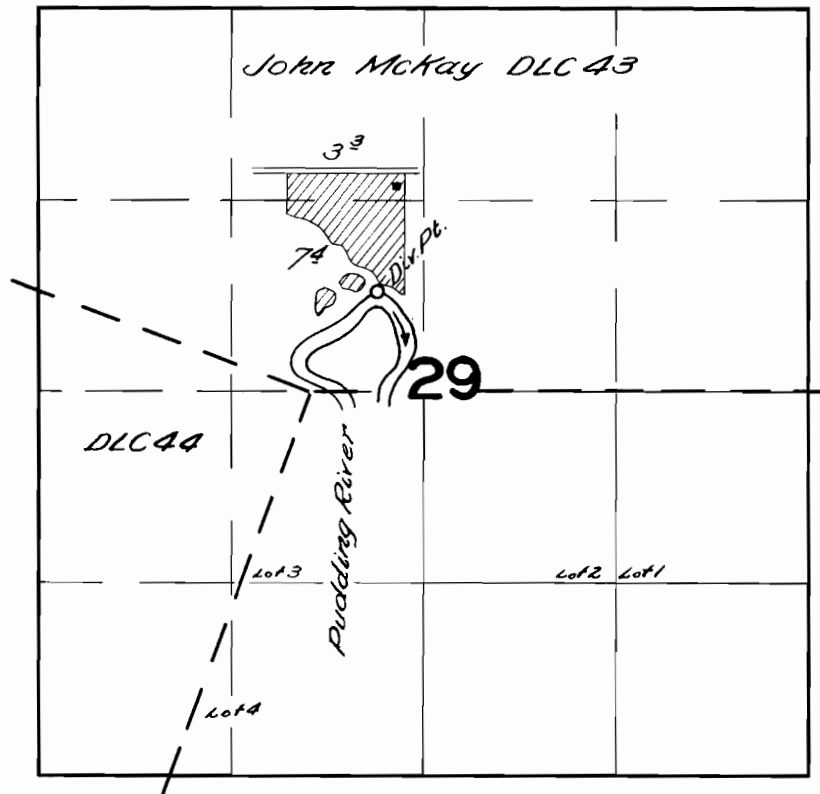

## FINAL PROOF SURVEY UNDER

Application No. 28965 Permit No. 22781...  
IN NAME OF

*Alton John Zollner*

Surveyed April 23 1958, by *C.O. Baile*