


T. 1 N. R. 5 W. W.M.

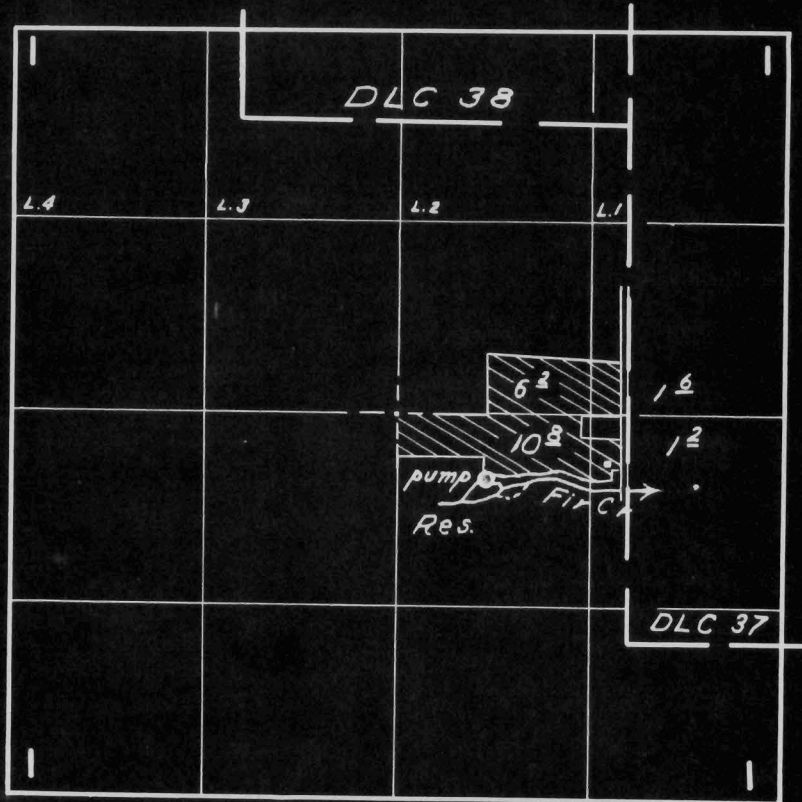

FINAL PROOF SURVEY
UNDER

28900 22903 primary
 R-29858 R-1853
 Application No. 30027 Permit No. 24159 suppl.

IN NAME OF
Emmet R. Shipley

Surveyed *May 9 1958*, by *R. H. Whitby*