


T. 1S. R. 2W. W.M.

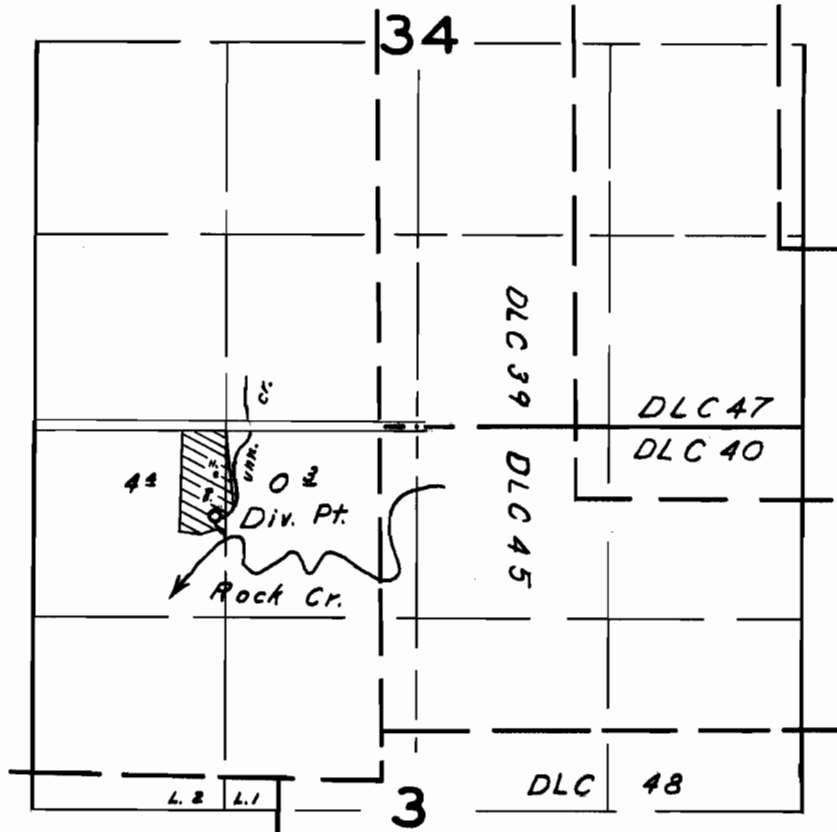

FINAL PROOF SURVEY
UNDER

Application No. 29200. Permit No. 22997
IN NAME OF

Kenneth W. Smith

Surveyed April 8, 1958, by *C.O. Bartels*