


T.27S.R.12&13W.W.M.

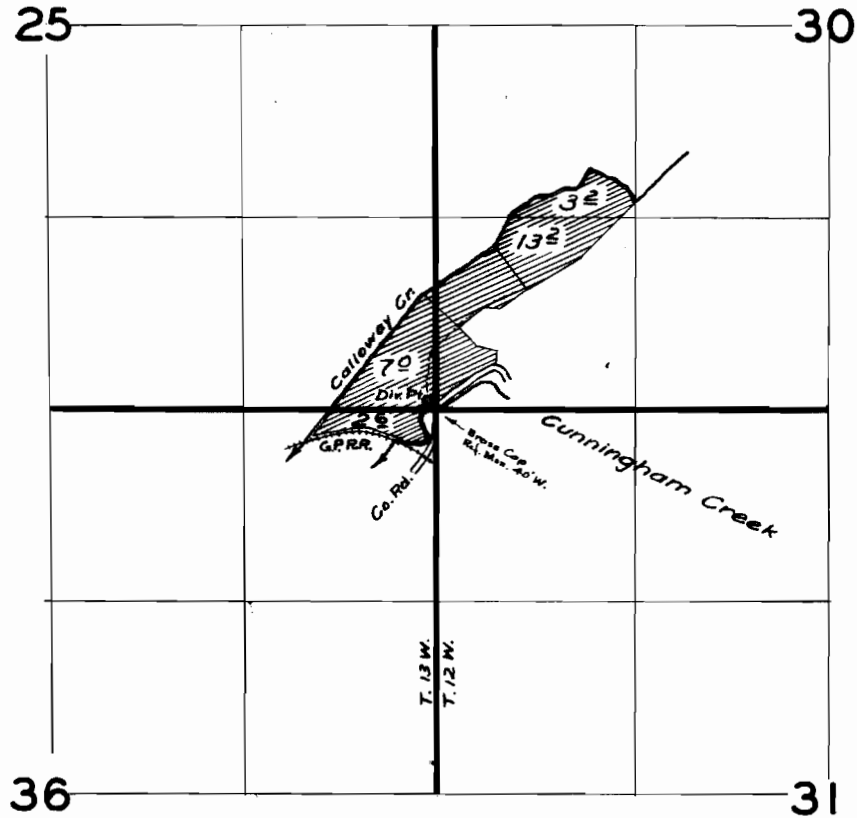

**FINAL PROOF SURVEY**  
UNDER

Application No. 28734 Permit No. 23057  
IN NAME OF

George H. Jenkins

Surveyed 12 June 1958 by T. B. Bish