


T. 23S. R. 32E. W.M.

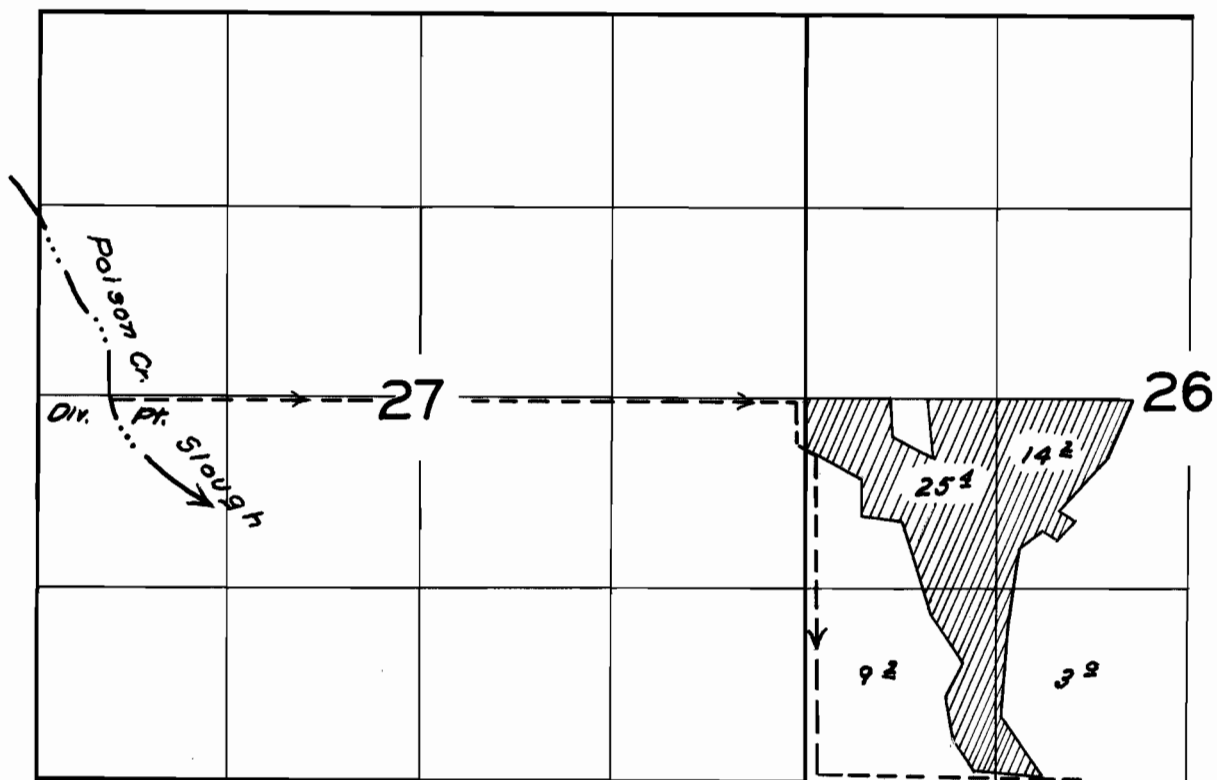

FINAL PROOF SURVEY
UNDER

Application No. 29377 Permit No. 23146
IN NAME OF

Wayne Howes

Surveyed July 23 1958, by W.N. Perry