


# T. 9 S. R. 1 W. W. M.

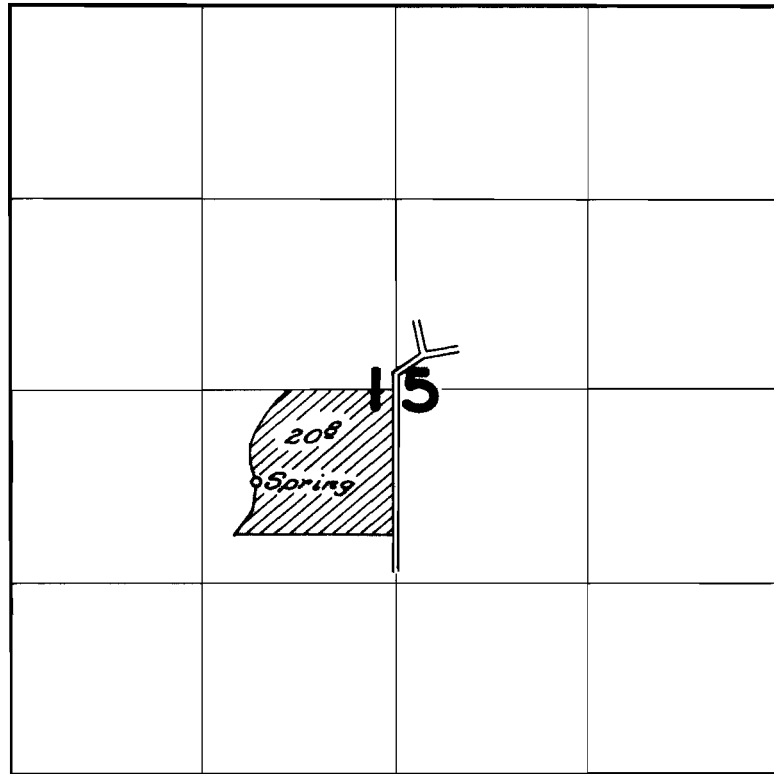

## FINAL PROOF SURVEY UNDER

Application No. 29491 Permit No. 23199  
IN NAME OF

*Howard Rosenbalm*

Surveyed July 18, 1958, by *C.R. Bartels*