


T.28S.R.12 W.W.M.

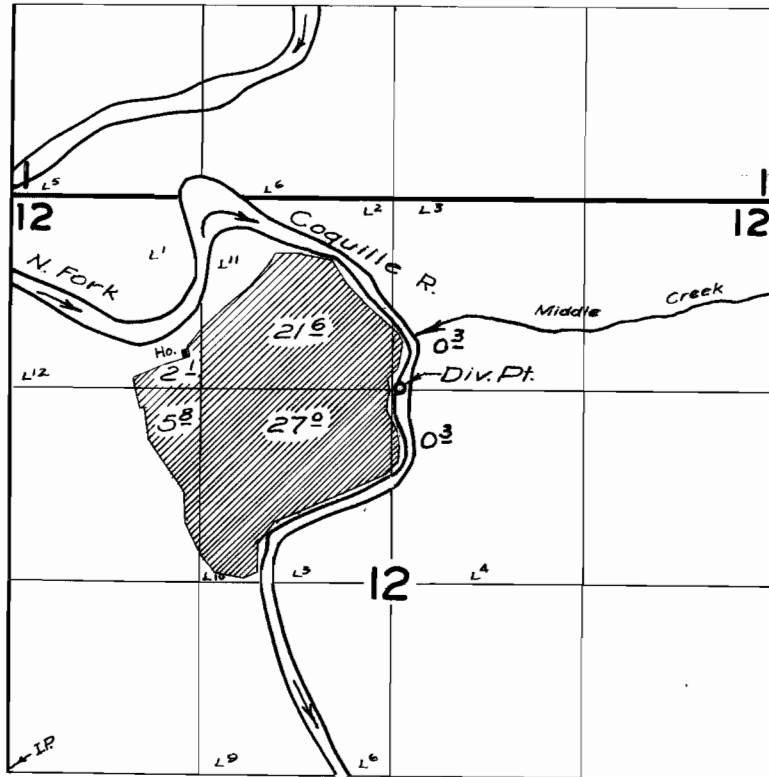

FINAL PROOF SURVEY
UNDER

Application No. 29520 Permit No. 23209
IN NAME OF

W. H. & C. O. Hervey

Surveyed 28 May 1958, by T. M. Bish