


T. 2S. R. 3E. W.M.

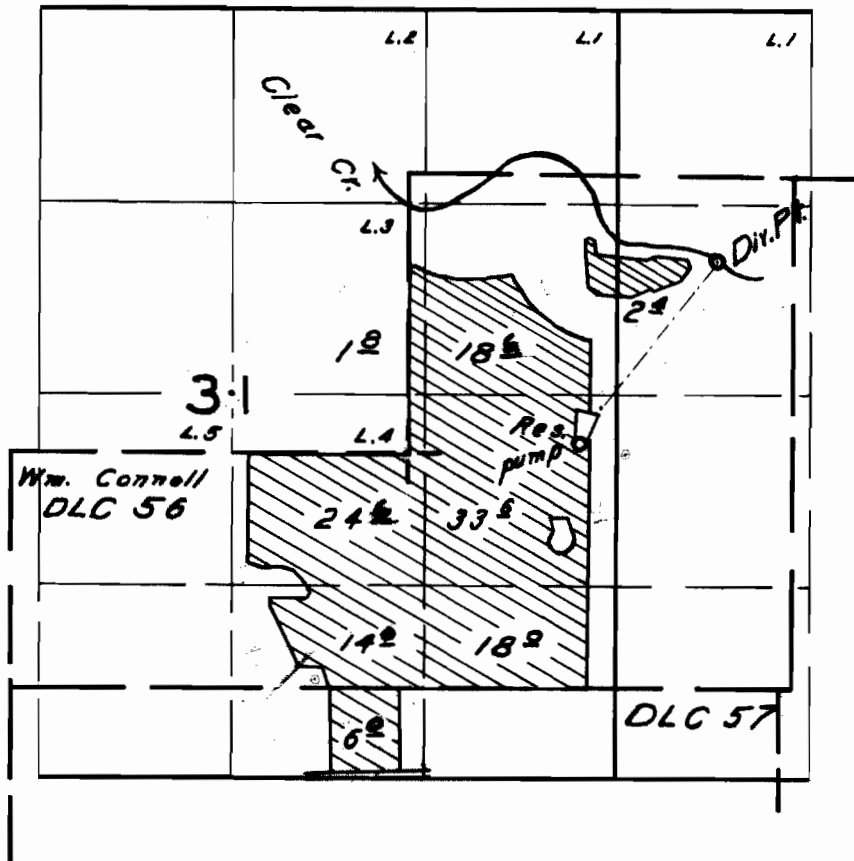

FINAL PROOF SURVEY
UNDER

R-30024 R-1715
Application No. ~~29998~~ Permit No. 23421
IN NAME OF

John F. Deininger

Surveyed *June 27 1958*, by *W. N. Perry*