


T. 9 S. R. 2 W. W. M.

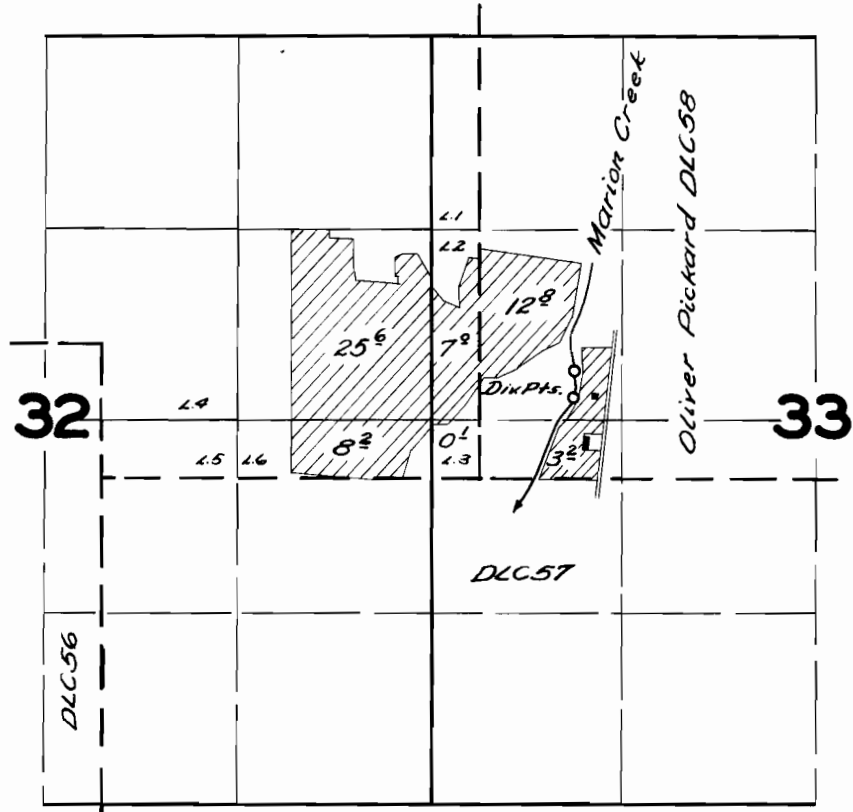

FINAL PROOF SURVEY UNDER

Application No. 29761 . Permit No 23439
IN NAME OF

Edward J. Gistler

Surveyed June 13, 1958, by *C. C. Baster*