


T. 2S. R. 2E. W.M.

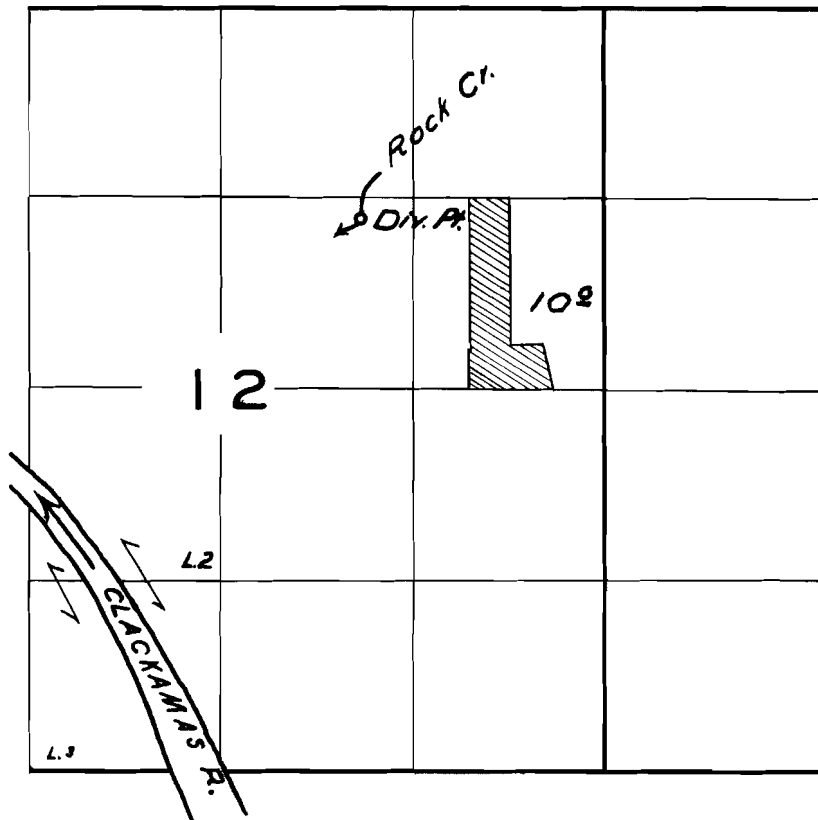

**FINAL PROOF SURVEY**  
UNDER

Application No. 30306 Permit No. 23731  
IN NAME OF

Paul Schweizer

Surveyed July 9, 1958, by W. N. Perry