


T.25 S.R.12 W.W.M.

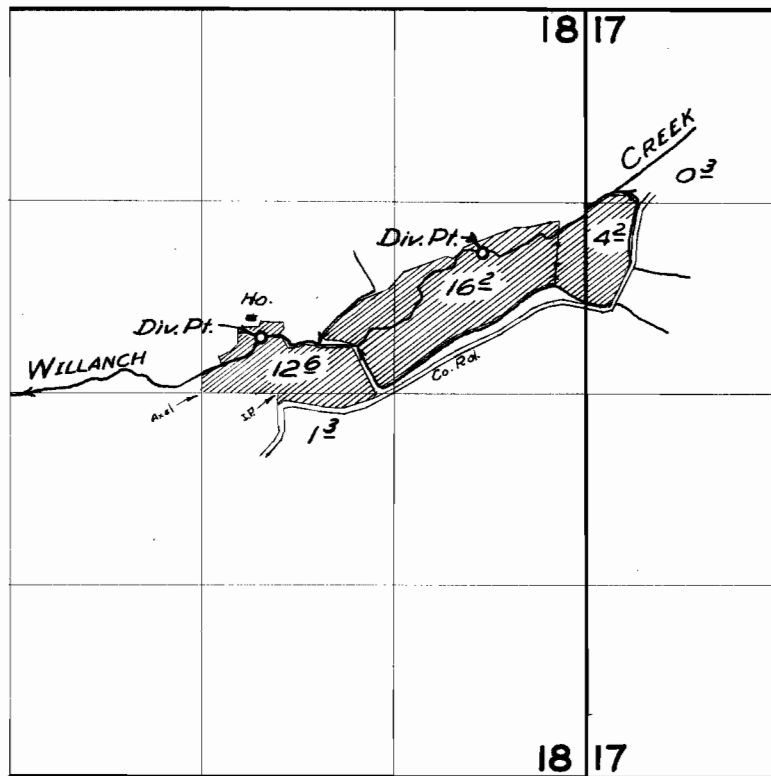

FINAL PROOF SURVEY
UNDER

Application No. 29326.. Permit No. 23927.
IN NAME OF

Harry W. Walker

Surveyed *14 July* 1958, by *Tom Bish*