


T.25S.R.12W.W.M.

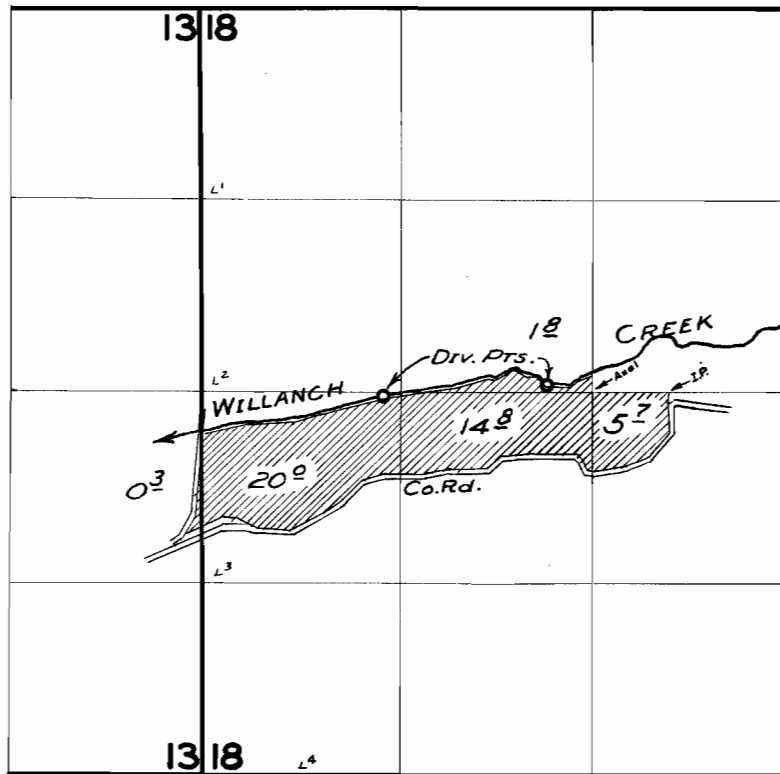

FINAL PROOF SURVEY
UNDER

Application No. 29333. Permit No. 23930
IN NAME OF

..... *Frank B. Rood, Jr.*

Surveyed 14 July 1958, by *Tom Bish*