


T.30 S.R.4 W.W.M.

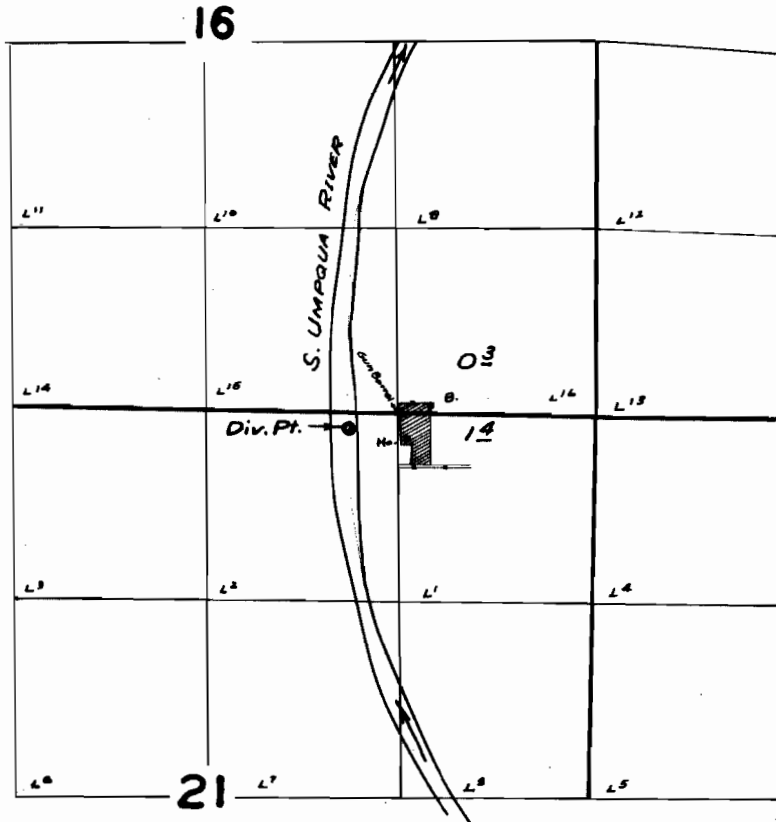

FINAL PROOF SURVEY
UNDER

Application No. 30197 Permit No. 23964
IN NAME OF

ROBERT M. THOMPSON

Surveyed 9 Sept. 1958, by M. B. Bish