


T.37S.R.14&15W.W.M.

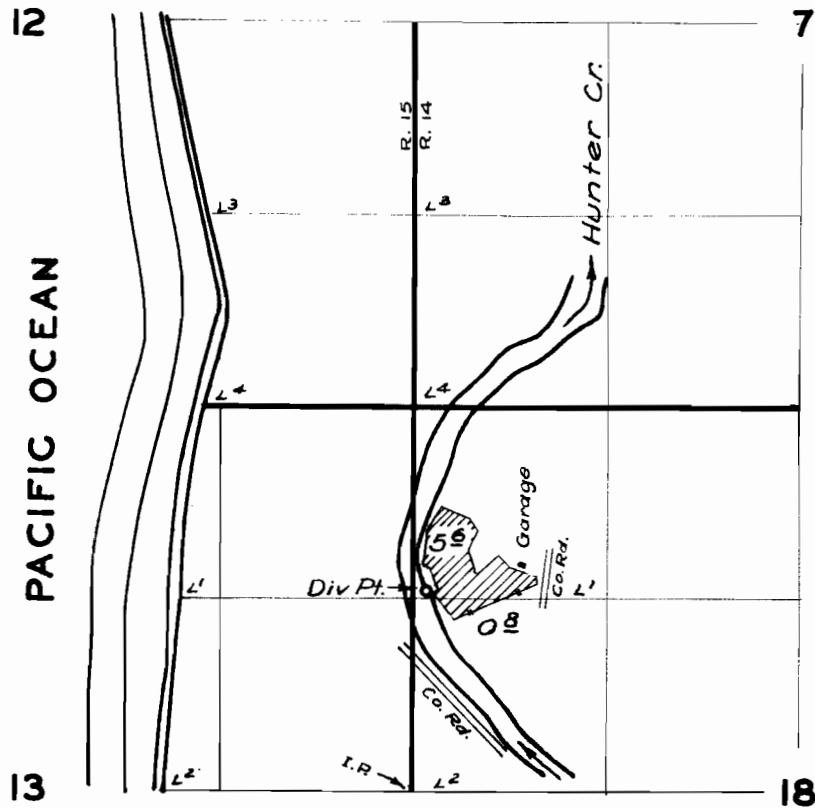

**FINAL PROOF SURVEY**  
UNDER

Application No. 30536 Permit No. 24043  
IN NAME OF

R.L. Bailor

Surveyed 26 Mar. 1958, by M. Bick