


# T.28 S.R.11 W.W.M.

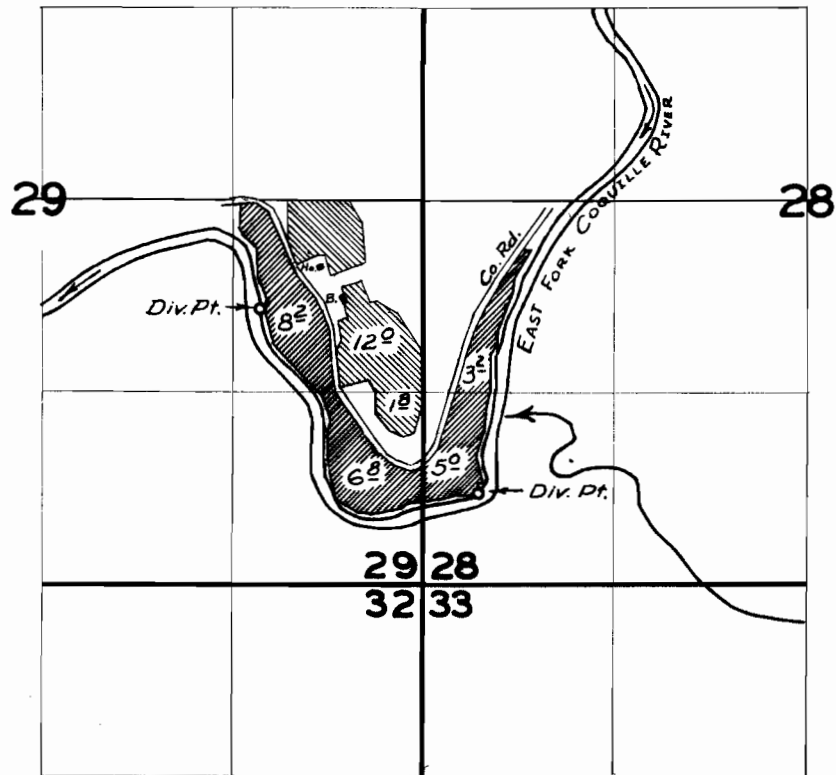

## FINAL PROOF SURVEY UNDER

27151                      21353  
Application No. 30539 Permit No. 24046  
IN NAME OF



SEVERT IVERSON

Surveyed 11 July 1958, by M. Bish