


T.28S.R.12W.W.M.

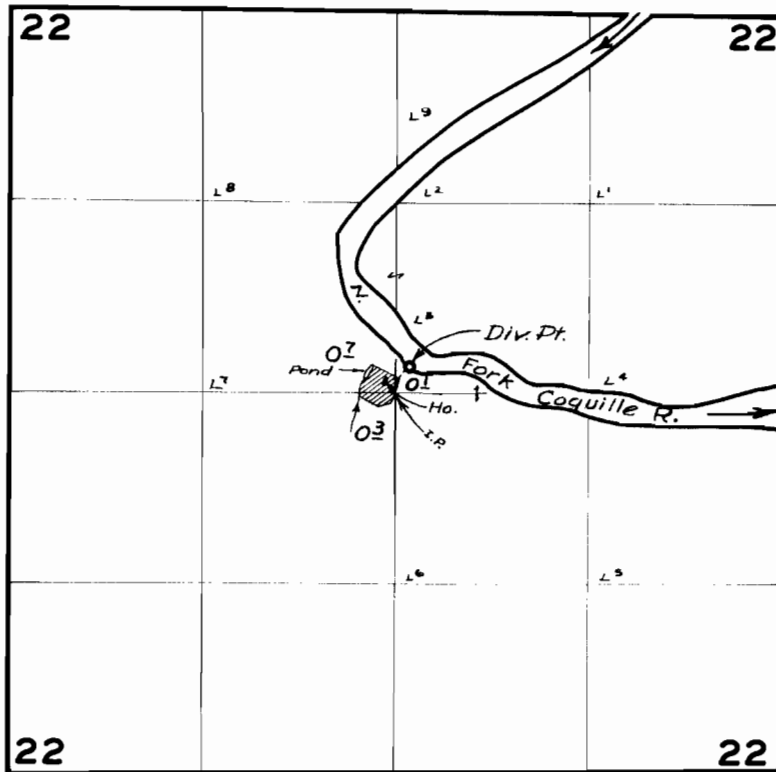

**FINAL PROOF SURVEY**  
UNDER

Application No. 30605 Permit No. 24097  
IN NAME OF

J. H. Bowen

Surveyed 25 May 1958, by M. B. Bish