


T. 9S. R. 4E. W.M.

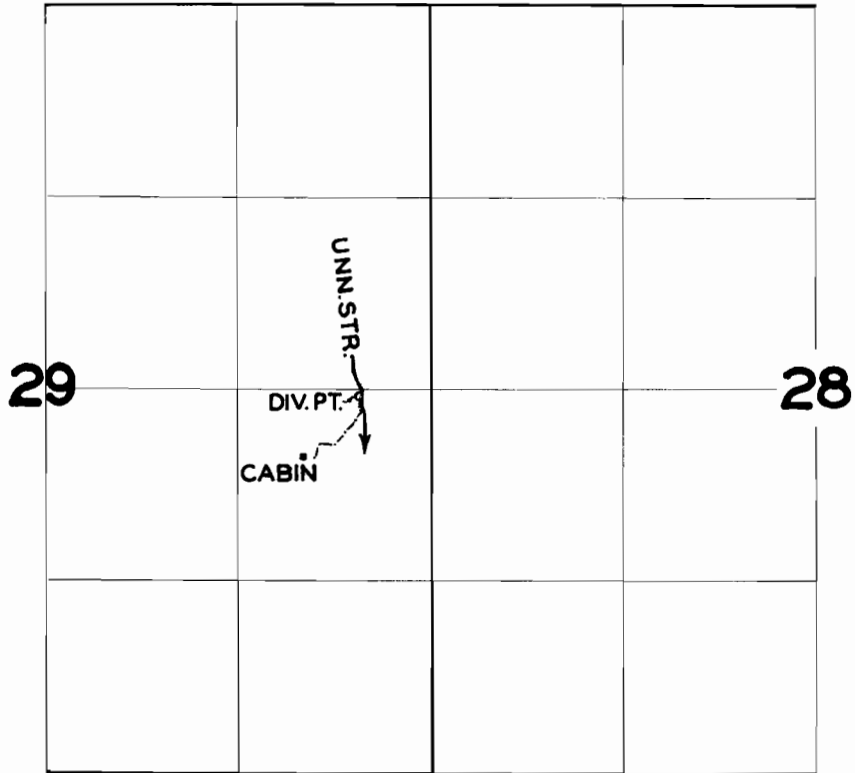

FINAL PROOF SURVEY
UNDER

Application No. 30749.. Permit No. 24225.
IN NAME OF

R. D. ADAMS

Surveyed MAY 14 1958, by *C. O. Bartels*