


T. 2S. R. 1E. W.M.

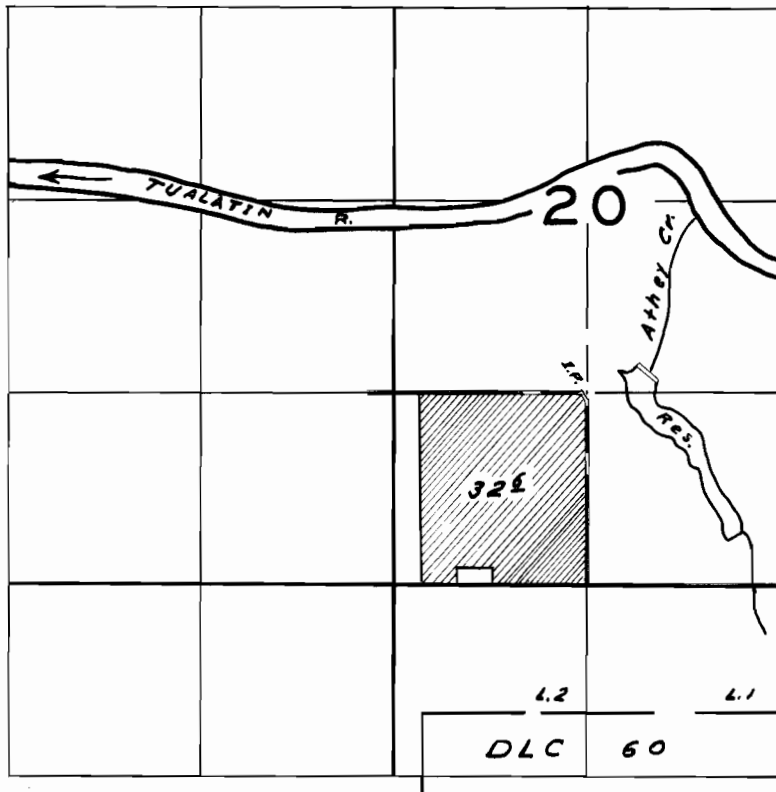

FINAL PROOF SURVEY
UNDER

Application No. 30786. Permit No. 24241.
IN NAME OF

Schaber Bros.

Surveyed July 30 1958, by W.N. Perry