


# T.29 S.R.14 W.W.M.

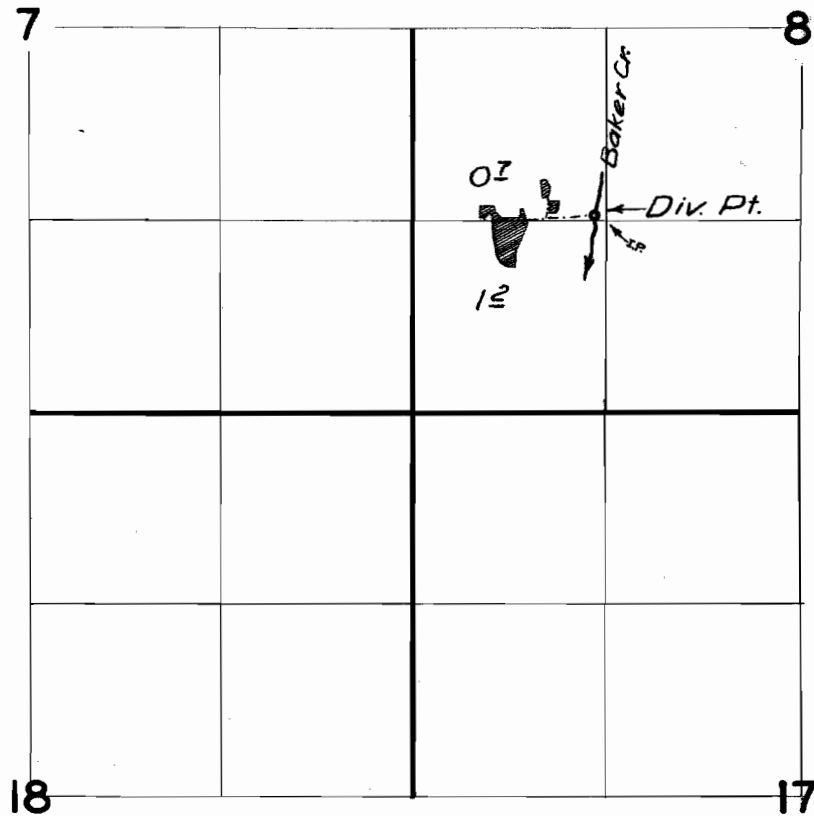

## FINAL PROOF SURVEY UNDER

Application No. 30997 Permit No. 24385  
IN NAME OF

Ora Baker

Surveyed 23 April 1958, by Tm. Bisher