


T. 9 S. R. 4 W. W. M.

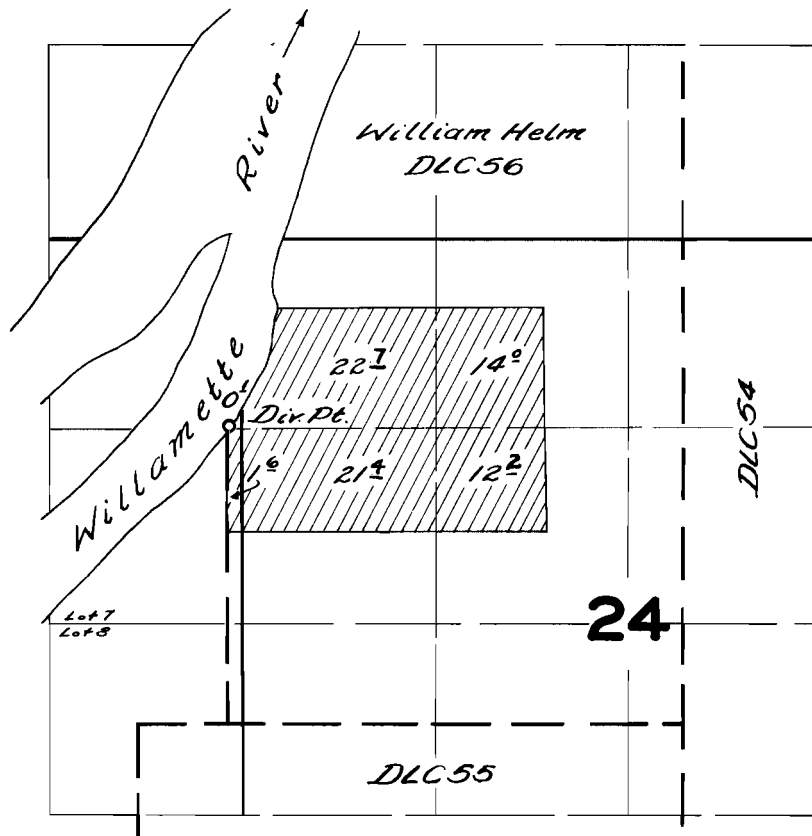

FINAL PROOF SURVEY UNDER

Application No. 31000. Permit No. 24450.
IN NAME OF

Nellie Wiederkehr

Surveyed *May 19, 1958*, by *C.O. Bartels*