


# T.36 S.R.15 W.W.M.

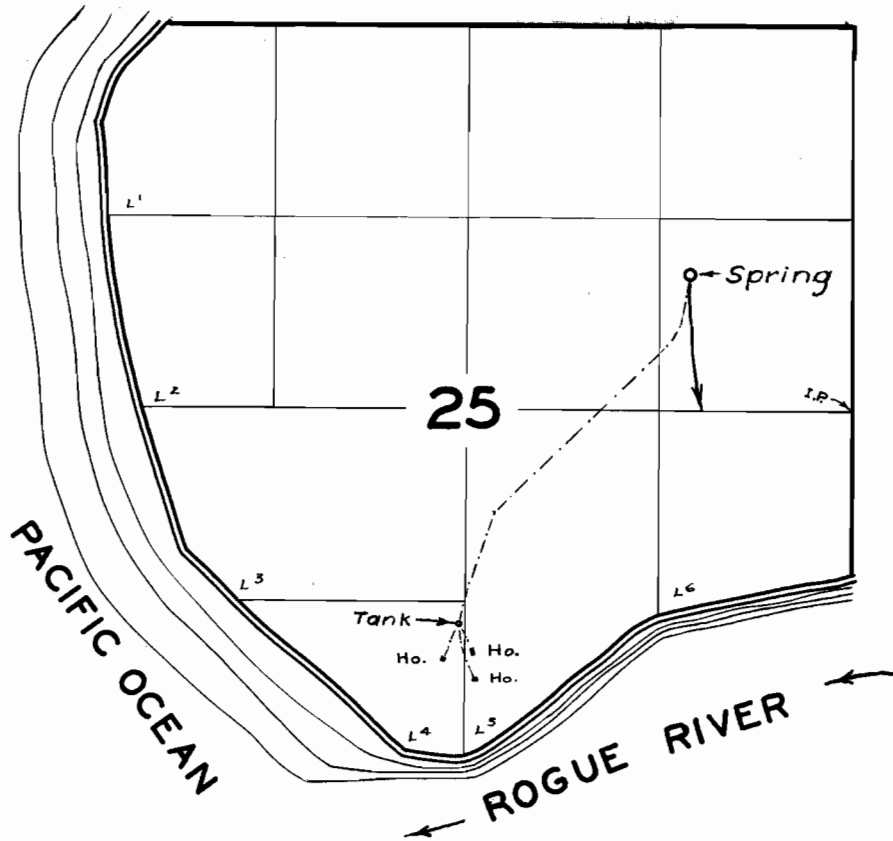

## FINAL PROOF SURVEY UNDER

Application No. 31635 Permit No. 24936  
IN NAME OF

Bernard I. & Alice B. Mather

Surveyed 27 Mar. 1958, by M. B. Beck