


# T.6S. R.1W.W.M.

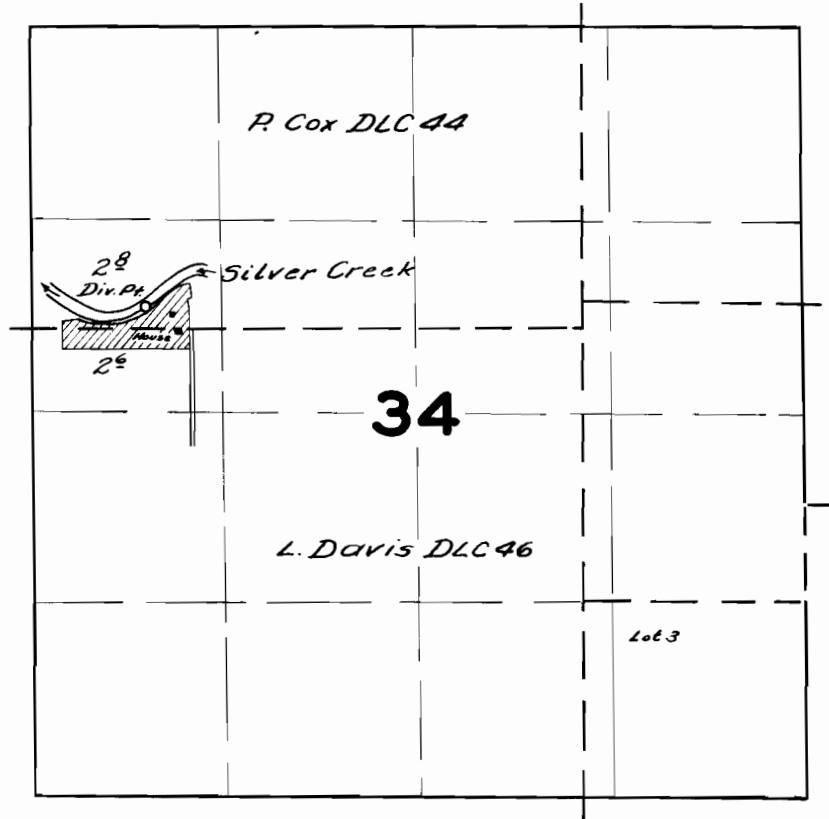

## FINAL PROOF SURVEY UNDER

Application No. 31591 Permit No. 24968  
IN NAME OF

Alfred E. & Phyllis E. Kyte

Surveyed April 16, 1958, by C.O. Bartels