


T. 1N. R. 3W. W.M.

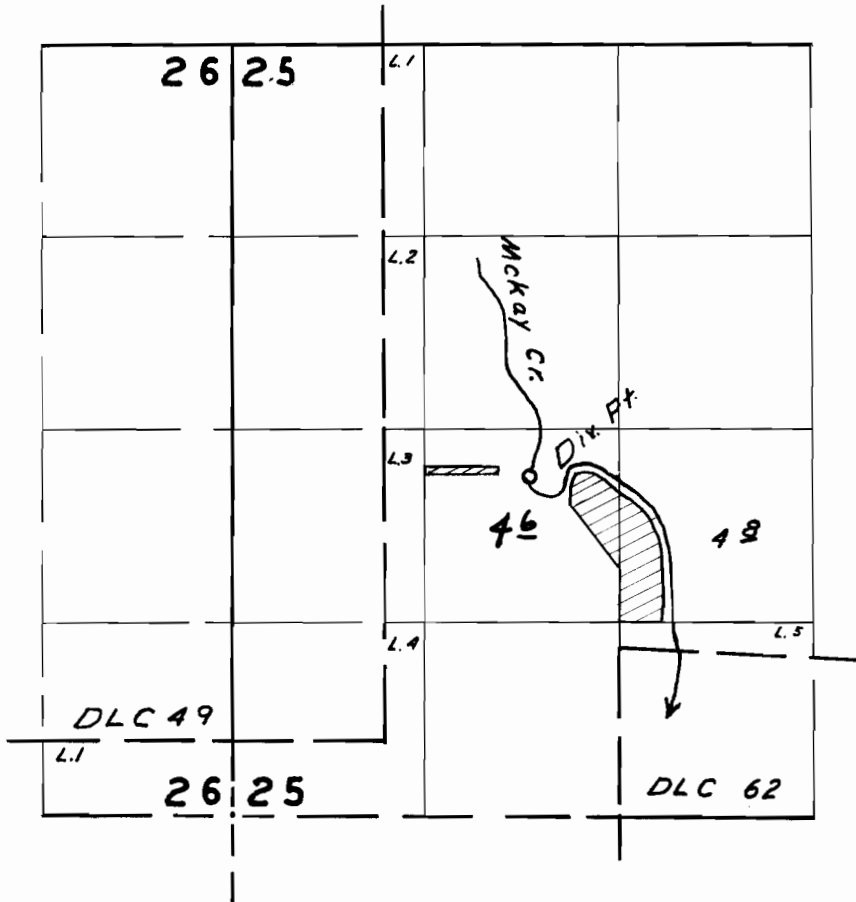

FINAL PROOF SURVEY
UNDER

Application No. *31801* Permit No. *25056*
IN NAME OF

Edward H. Sahfeld

Surveyed *April 29 1958*, by *R. H. Whitby*