


T.6S. R.3W.W.M.

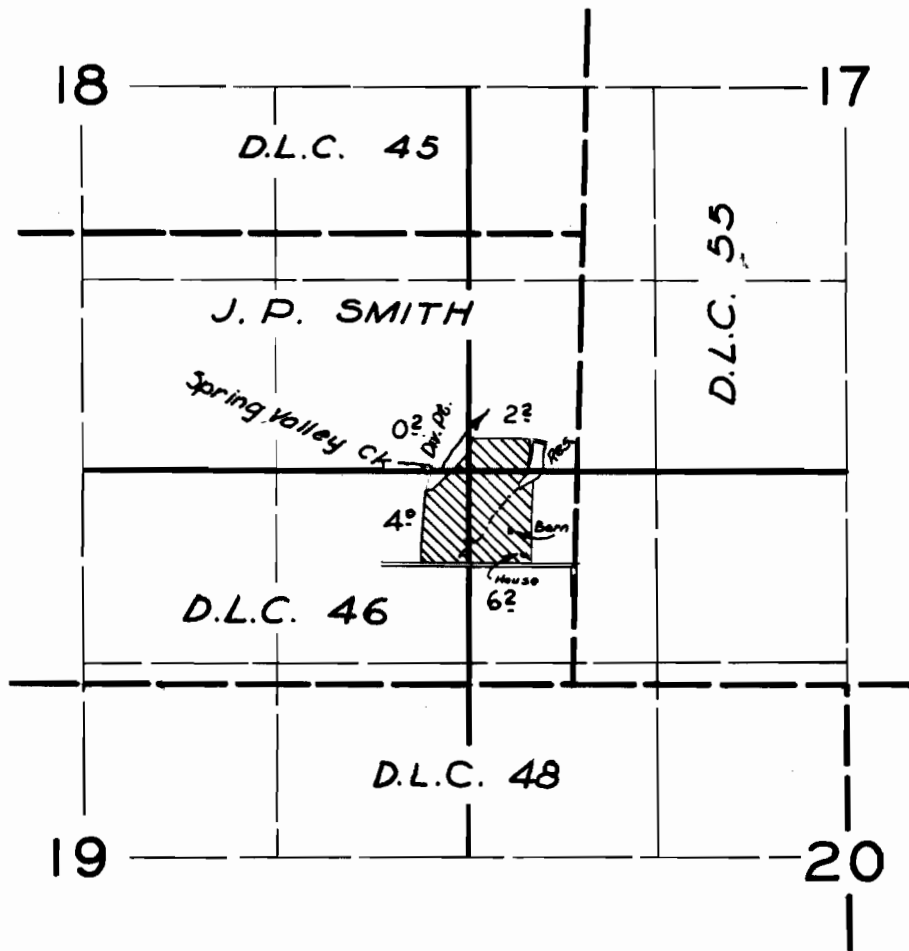

FINAL PROOF SURVEY
UNDER

Application No. 31952... Permit No. 25189...
IN NAME OF

Virgil R. & Jean H. Punzel

Surveyed 10 Nov. 1958, by C.O. Bartels.