



T. 6 S. R. 3 W. W. M.

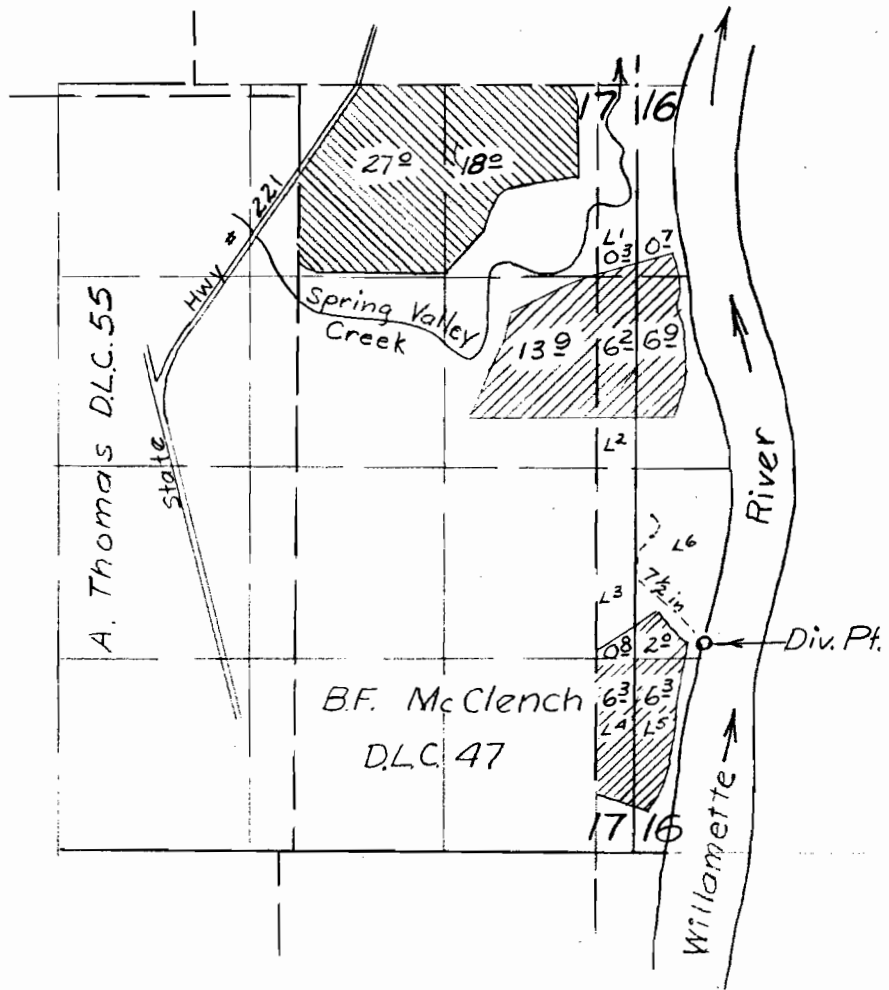

Supplemental 
to Permit 21295

CAN BE USED
AS FINAL PROOF
AS PER CERT # 26360

Frank B. Windsor

Application No. 32099

Permit No. 25331