


T. 11S. R. 4W.W.M.

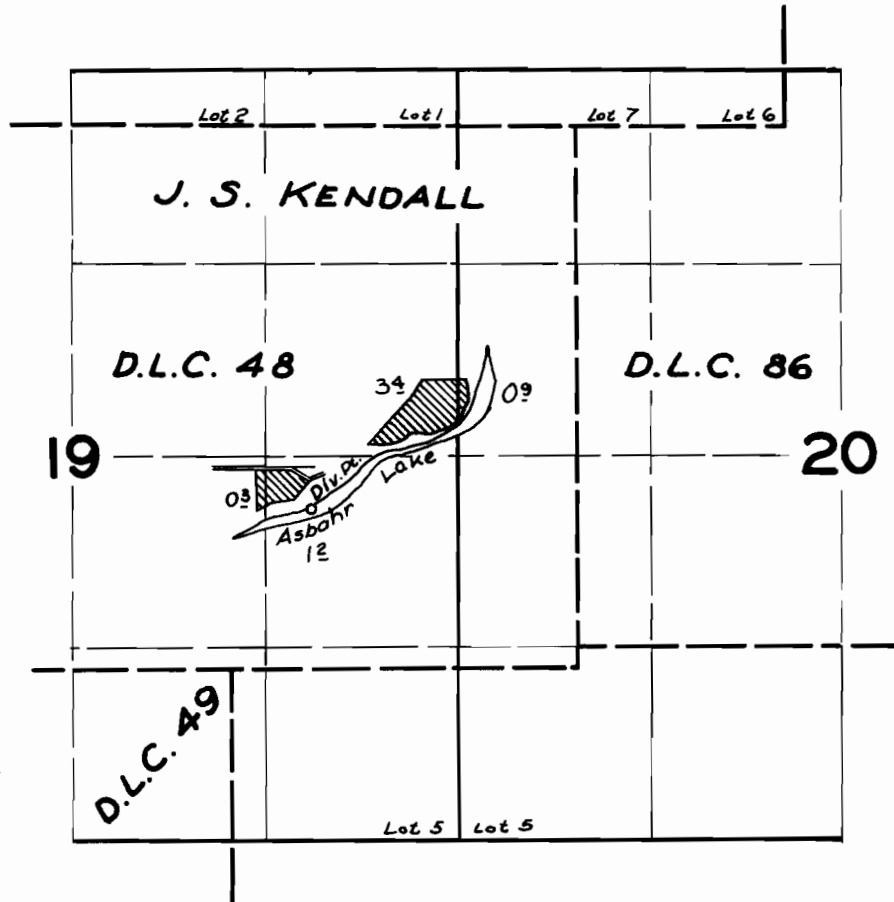

FINAL PROOF SURVEY
UNDER

Application No. 32243. Permit No. 25437.
IN NAME OF

ANNIE EMMA PILKINGTON-MARY AGNES PILKINGTON

Surveyed 19 Sept. 1958, by M. Bish

RT