


T. 9S. R. 40E.W.M.

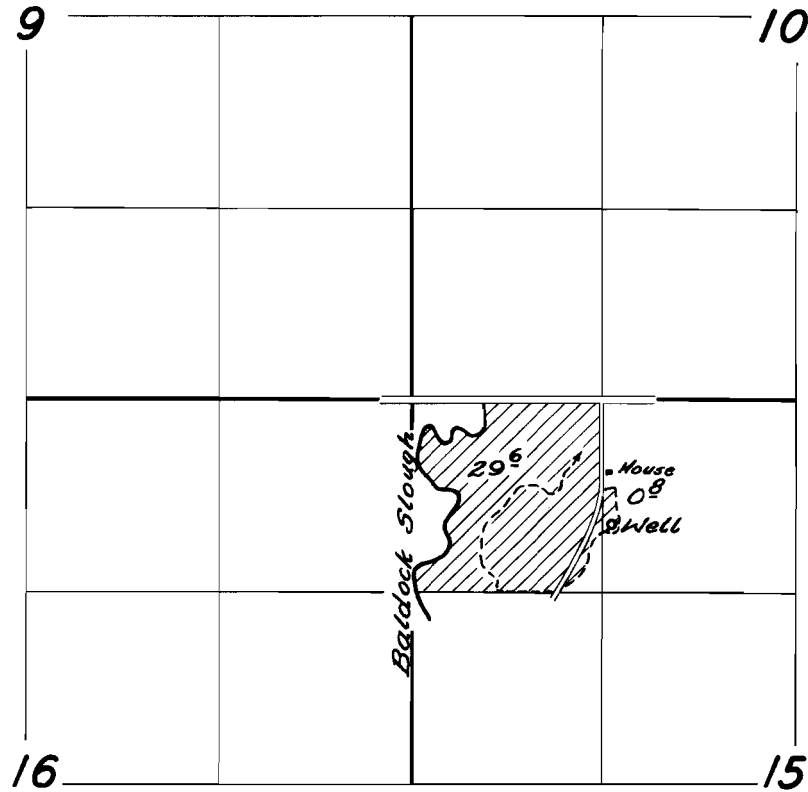

FINAL PROOF SURVEY
UNDER

Application No. *41-121* Permit No. *41-115*
IN NAME OF

ROY KNIGHT

Surveyed *Sept. 19* 1958, by *C.D. Bartlett*