


T. 20S. R. 36E. W.M.

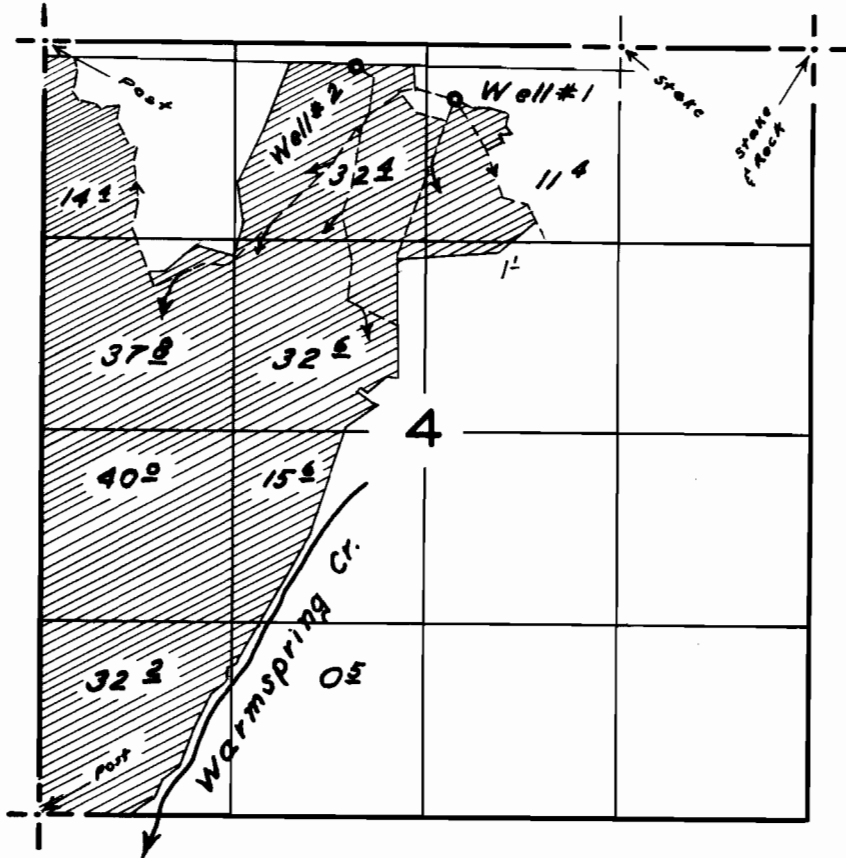

FINAL PROOF SURVEY
UNDER

Application No. *U-194* Permit No. *U-176*
IN NAME OF

Jos. W. Altnow of Altnow & Sons

Surveyed *Aug. 19 1958*, by *W. N. Parry*