


T. 23 S. R. 34 E. W.M.

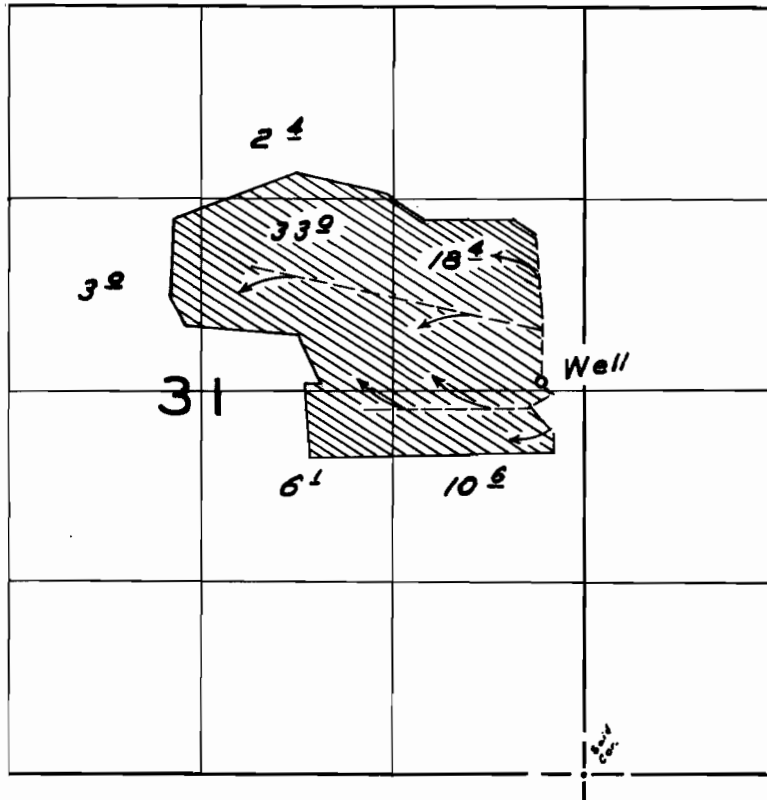

FINAL PROOF SURVEY
UNDER

Application No. U-331 Permit No. U-305
IN NAME OF

Miller Bros.

Surveyed Sept. 21 1958, by W. N. Perry