


T. 25 S. R. 34 & 35 E. W.M.

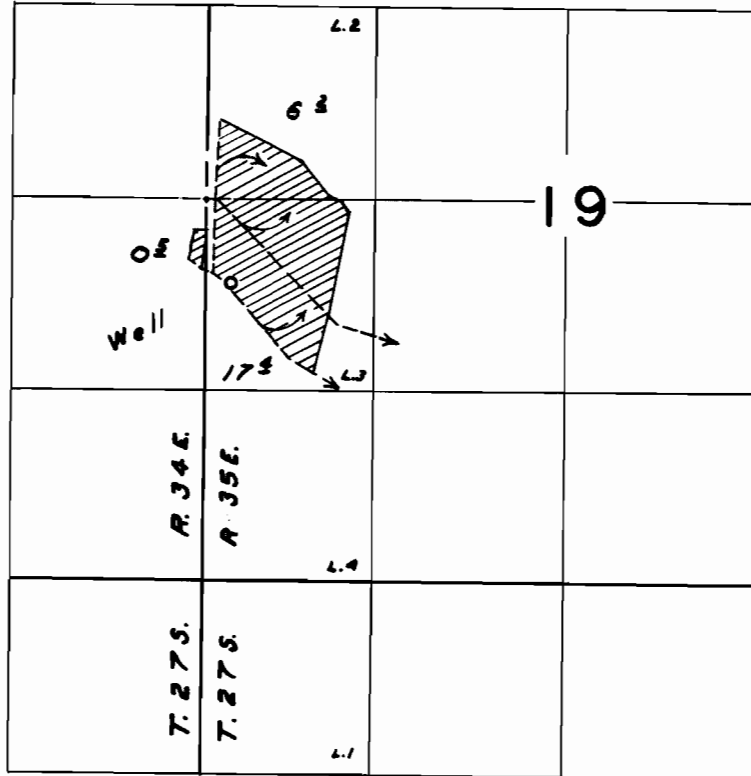

**FINAL PROOF SURVEY**  
UNDER

Application No. U-680 Permit No. U-612  
IN NAME OF

..... C. L. Wright .....

Surveyed Sept. 21 1958, by W. N. Perry.....