


T. 3S. R. 1E. W.M.

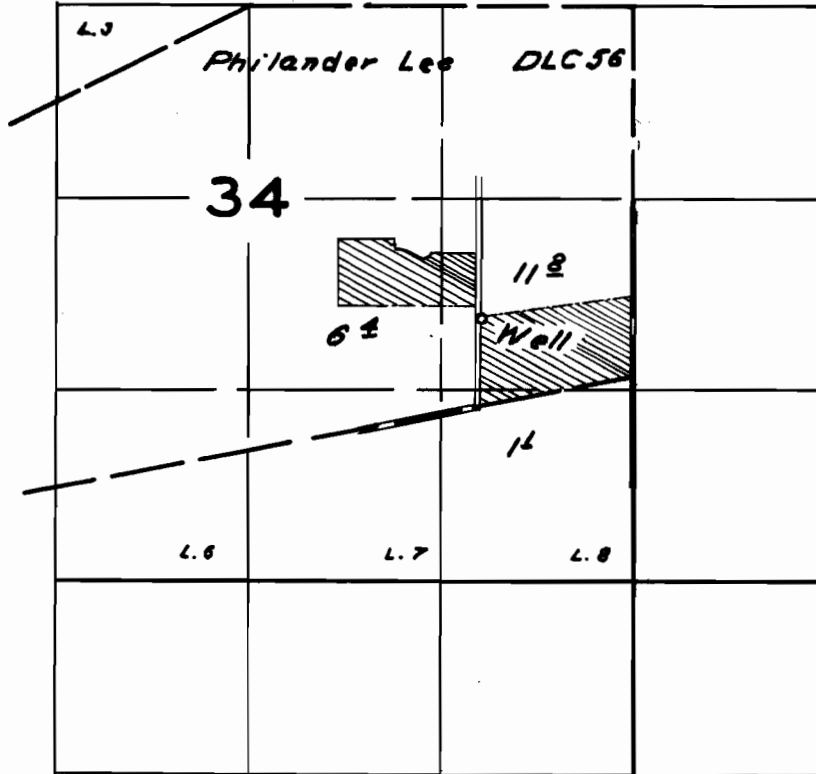

**FINAL PROOF SURVEY**  
UNDER

Application No. *G-235* Permit No. *G-114*  
IN NAME OF

*Emil P. Kraft*

Surveyed *Sept. 2 1958* by *W. N. Perry*