


T. 17S. R. 3W. W.M.

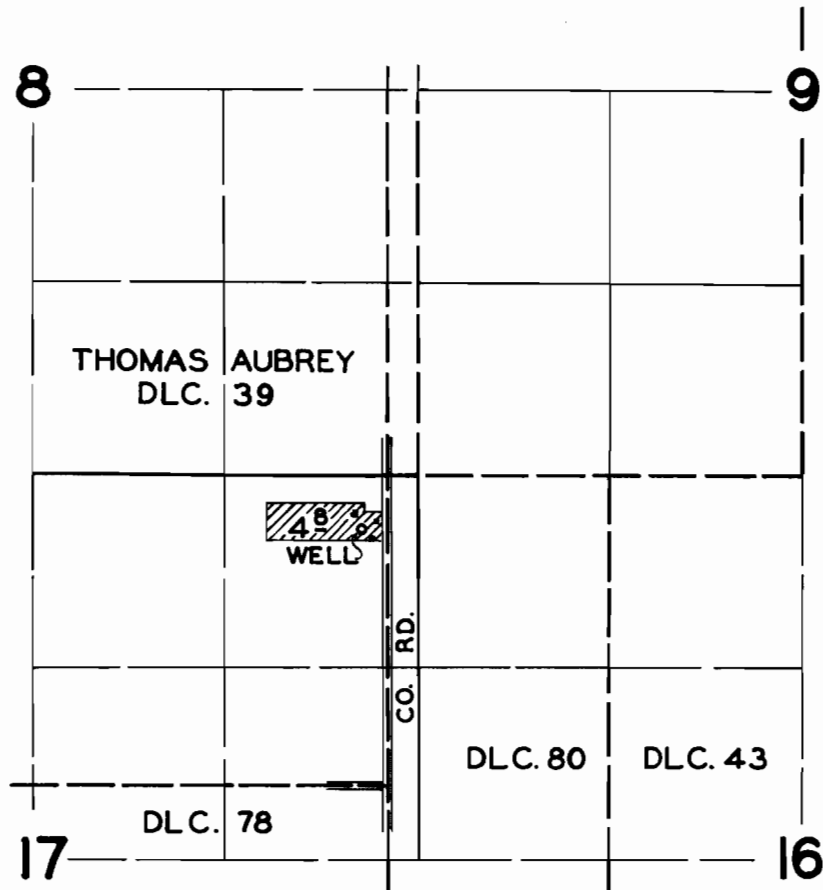

**FINAL PROOF SURVEY**  
UNDER

Application No. G-209 Permit No. G-128  
IN NAME OF

**A. L. DILLINGHAM**

Surveyed MAY 27, 1958, by *C. D. Smith*