


T. 4 S. R. 1 E. W. M.

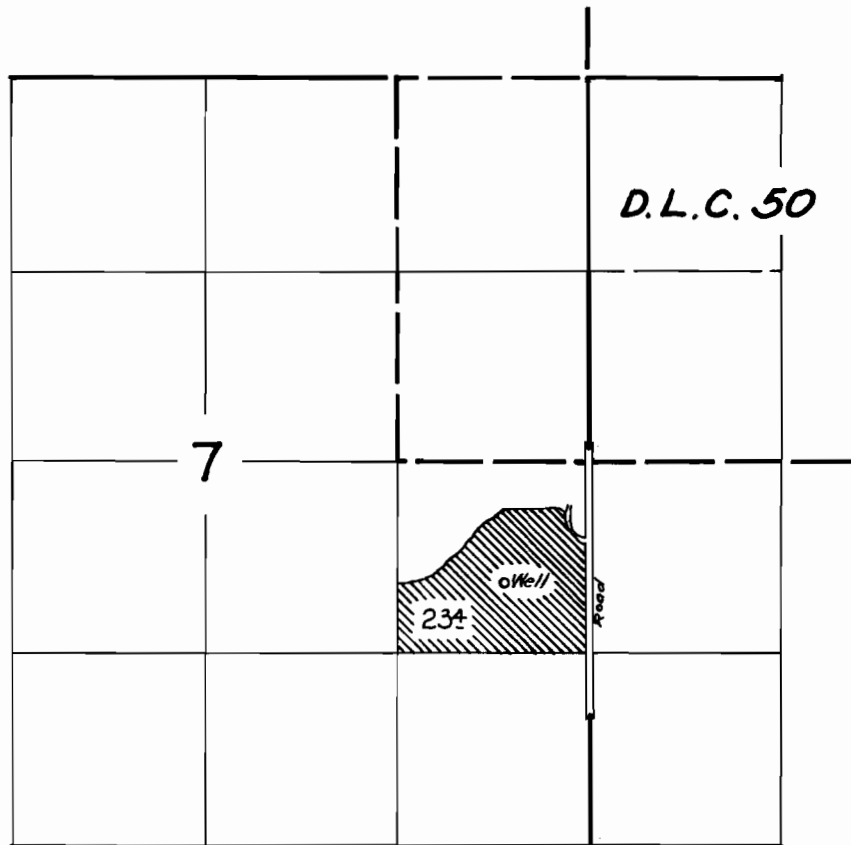

FINAL PROOF SURVEY
UNDER

Application No. G-252 Permit No. G-162
IN NAME OF

I. V. BANY

Surveyed 13 August 1958, by C.O. Bartels.