


T.5S. R.1W.W.M.

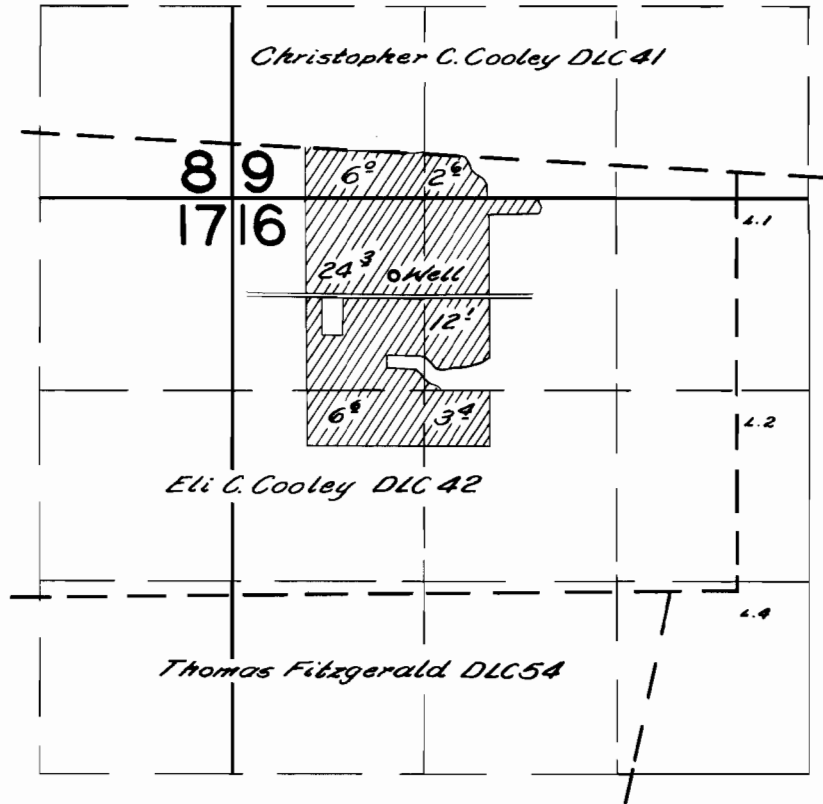

**FINAL PROOF SURVEY**  
UNDER

Application No. *G-276* ... Permit No. *G-188* ...  
IN NAME OF

*Dave A. Dryden*

Surveyed *April 24 1958*, by *C.D. Bar Esq.*