


T. 6 S. R. 2 W. W.M.

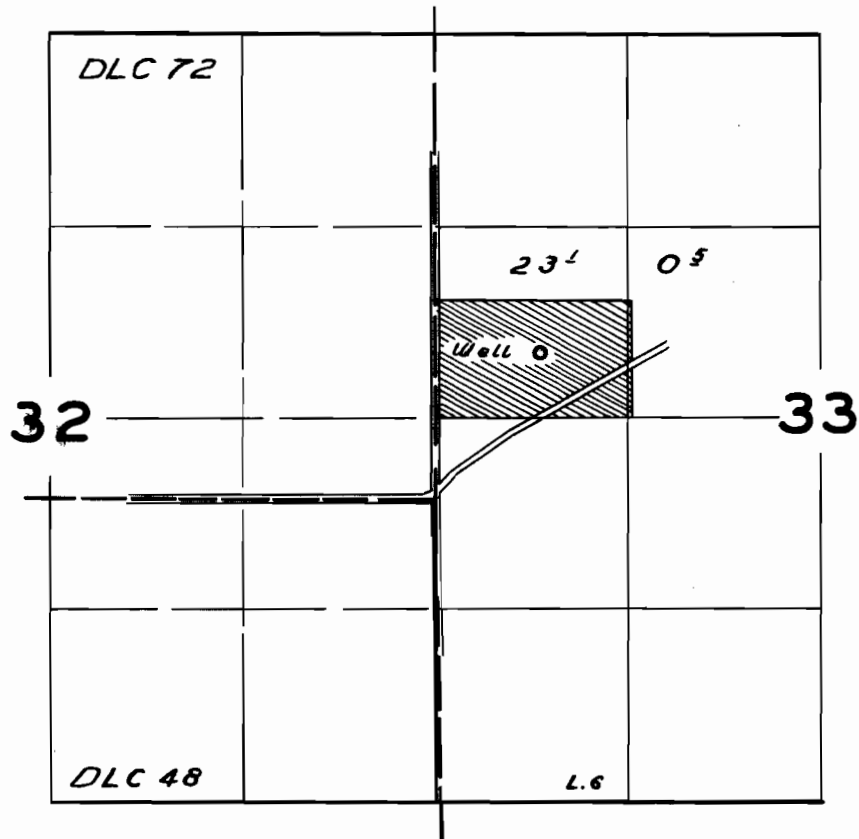

FINAL PROOF SURVEY
UNDER

Application No. *G-390* Permit No. *G-264*
IN NAME OF

Edgar N. Long

Surveyed *June 23 1958*, by *M. Bish*