


T.6S. R.3W.W.M.

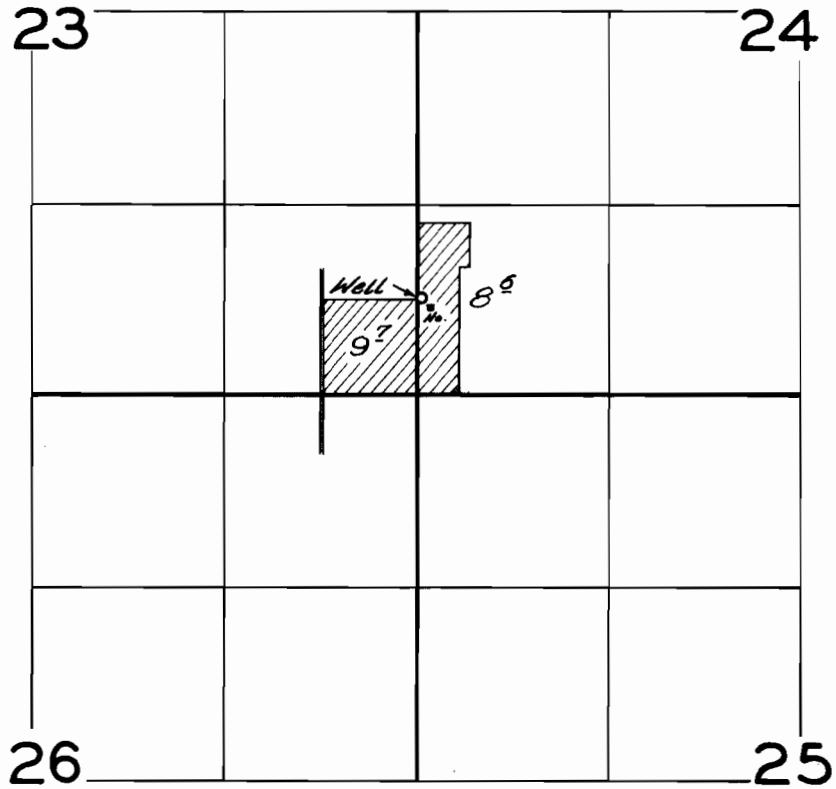

**FINAL PROOF SURVEY**  
UNDER

Application No. *G-649*... Permit No. *G-543*...  
IN NAME OF

.....*Allen Lee*.....

Surveyed *June 12, 1958*, by *C.D. Bantle*.....