


T. 9S. R. 4W. W.M.

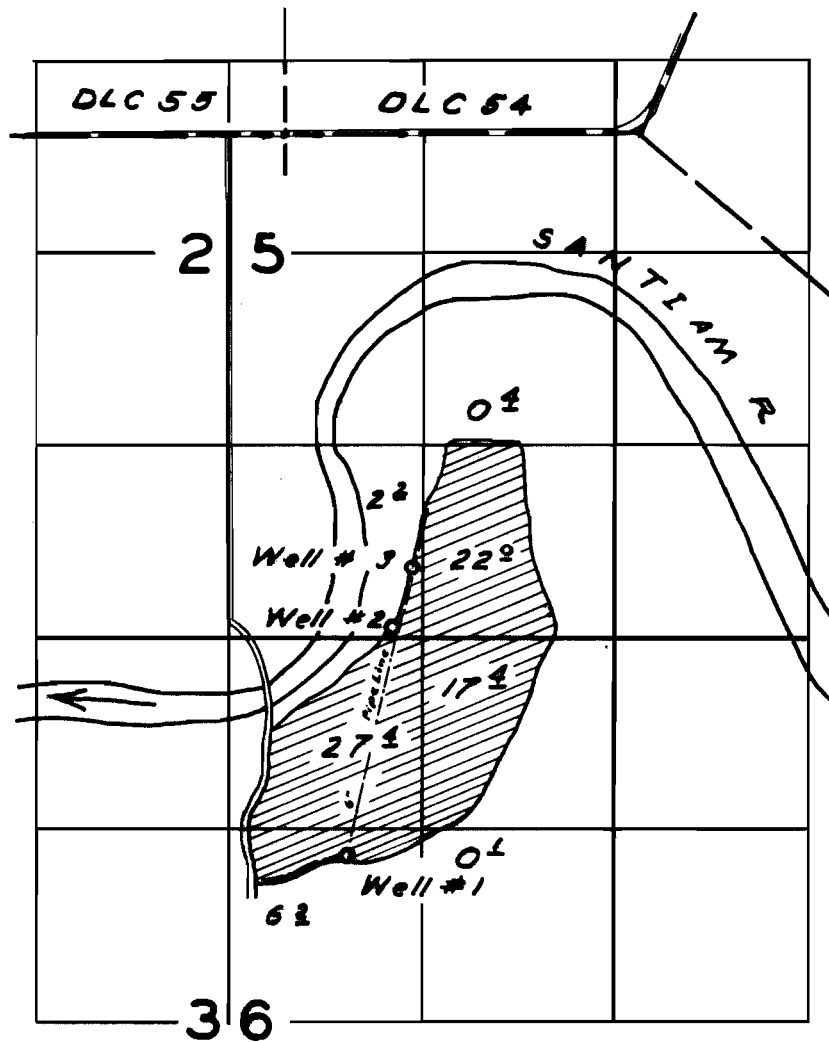

FINAL PROOF SURVEY
UNDER

Application No. G-782 Permit No. G-683
IN NAME OF

Glenn Edwards

Surveyed Sept. 5 1958, by W. N. Perry