


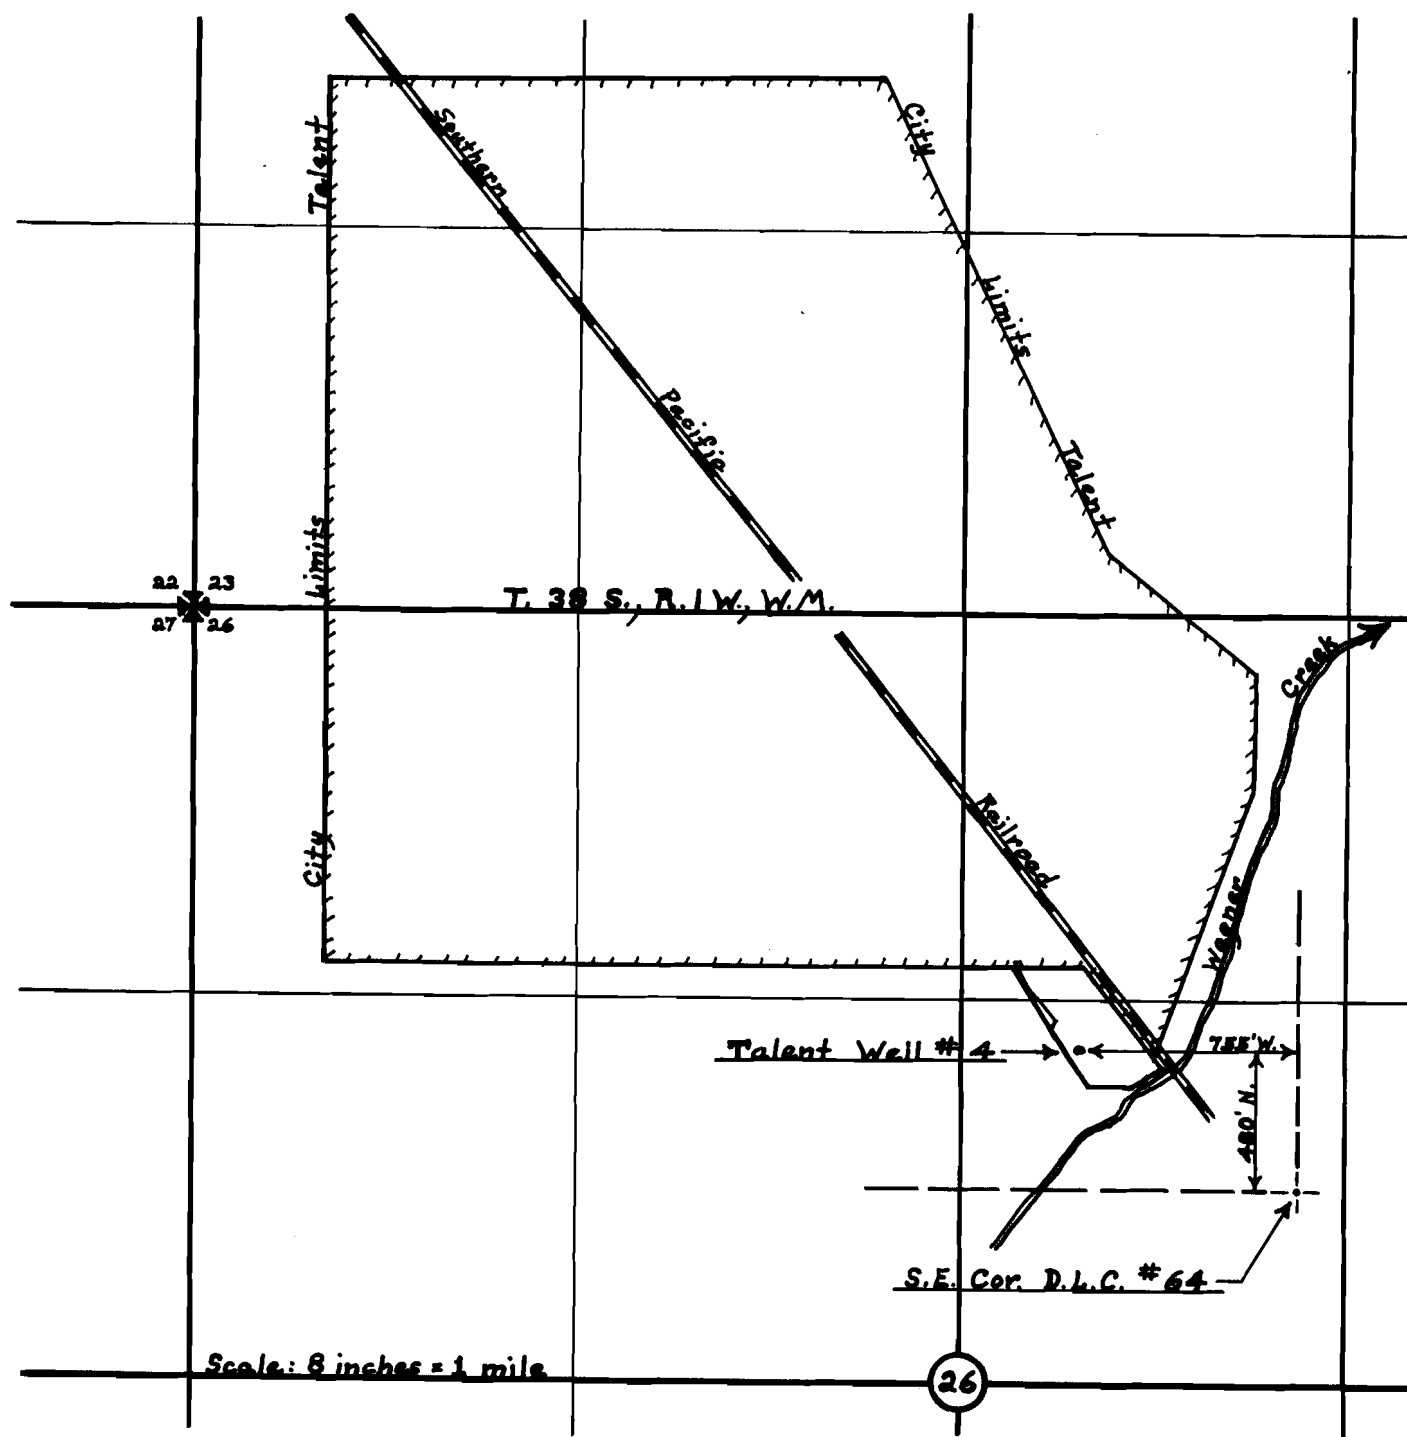

FINAL PROOF SURVEY UNDER

Application No. G-1575 Permit No. G-1436
IN NAME OF

City of Talent

Surveyed Dec. 1, 1959, by D.C. Hendrix, W.M.

RECORDED
INDEXED
JAN 10 1960
S.E. COR. D.L.C. #64