


T. 9 S. R. 45 E. W.M.

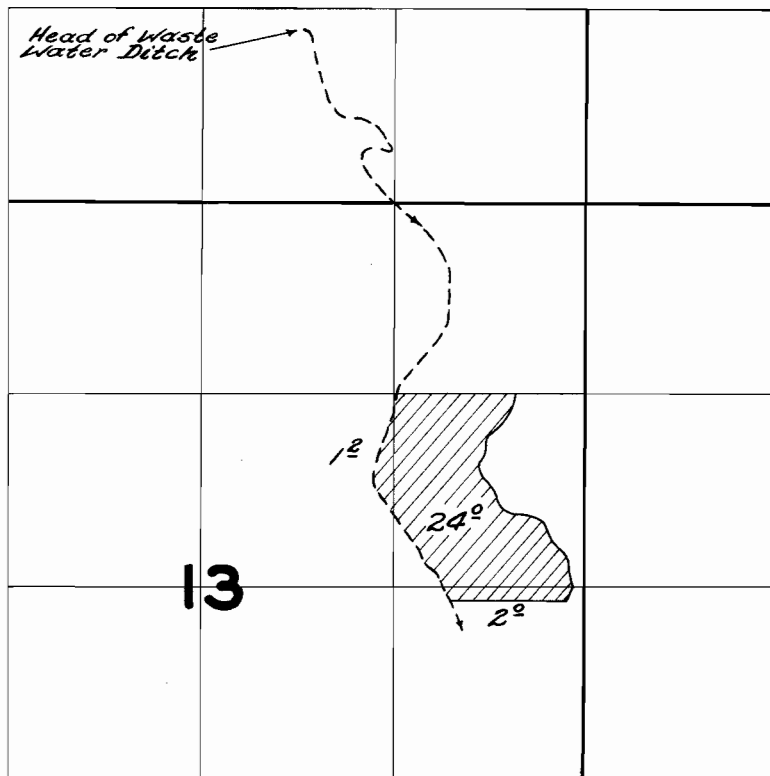

FINAL PROOF SURVEY UNDER

Application No. *17748* Permit No. *13442*
IN NAME OF

Estate of C.H. Brooks

Surveyed *Aug. 26 1958*, by *C.O. Barrett*